

MISSISSIPPI DEPARTMENT OF NATURAL RESOURCES

Bureau of Land and Water Resources

Southport Mall

P.O. Box 10631

Jackson, Mississippi 39209

WATER WELL DRILLERS LOG

PIKE
E
2059

6-13 1986 Fitzgerald well Sew Pike
date well completed firm name county well located

LANDOWNER:
Maie Ward
R.R. 2, M Comb, ms.
(mailing address)


description of formations encountered	from	to
<u>Red clay</u>	<u>0</u>	<u>20</u>
<u>Red sand</u>	<u>20</u>	<u>90</u>
<u>Coarse sand & gravel</u>	<u>90</u>	<u>121</u>

WELL LOCATION:
sec. 14 T. 3 N. R. 8 E
S W
5 miles E of M Comb
(distance) (direction) (nearest town)

WELL PURPOSE: Home
(home, irrigation, municipal, industrial)

WELL COMPLETION DATA:

- (1) diameter (inches) 4
- (2) total depth (feet) 121
- (3) static water level (feet) 95 below above top of ground.
- (4) casing A/C, 111,
(material) (depth)
4 if telescope see back.
(size)
- (5) screen 16, 111
(length) (depth to top)
4, A/C
(size) (material)
- (6) pump 1/2 10
(HP) (yield gpm)
Elec
(type power)
- (7) electric log No
(yes or no)
(organization running log)
- (8) how well bottom plugged Seal block

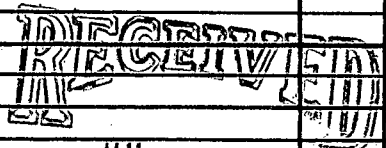


JUL 21 1986

Department of Natural Resources
Bureau of Land & Water Resources

DRILLERS REMARKS:

If well telescopes please sketch and show depths.

GROUND LEVEL

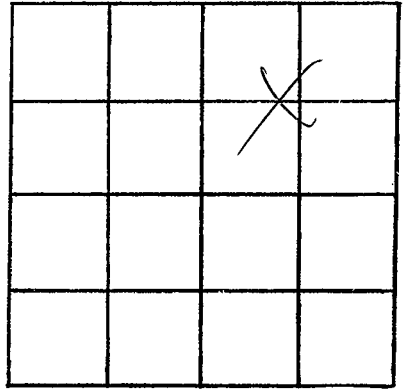

SECTION 14

Please indicate well location X.

ADDITIONAL INFORMATION

If more than one screen,
show locations of each on sketch.