

MISSISSIPPI DEPARTMENT OF NATURAL RESOURCES
Bureau of Land and Water Resources
Southport Mall
P.O. Box 10631
Jackson, Mississippi 39209
WATER WELL DRILLERS LOG

<u>PIKE</u>
<u>E 2061</u>

10-26 1986 Fitzgerald Well Serv Pike
date well completed firm name county well located

LANDOWNER:	description of formations encountered	from	to
<u>Calvin Carless -</u>			

<u>R.O. Box Farnwood, Ms.</u> (mailing address)	<u>Red clay</u>	<u>0</u>	<u>20</u>
	<u>Red sand</u>	<u>20</u>	<u>80</u>
	<u>Coarse sand & gravel</u>	<u>80</u>	<u>97</u>

WELL LOCATION:
sec. 29 T 3 N R 8 E
 S W
2 miles E of Farnwood
(distance) (direction) (nearest town)

WELL PURPOSE: Home
(home, irrigation, municipal, industrial)

WELL COMPLETION DATA:

(1) diameter (inches) 4

(2) total depth (feet) 97

(3) static water level (feet) 45 below above top of ground.

(4) casing PVC 87,
(material) (depth)
4 If telescope see back.
(size)

(5) screen 10 87
(length) (depth to top)

4 PVC
(size) (material)

(6) pump 1/2 10
(HP) (yield gpm)


cl
(type power)

(7) electric log No
(yes or no)

(organization running log)

(8) how well bottom plugged sand sh

DRILLERS REMARKS:

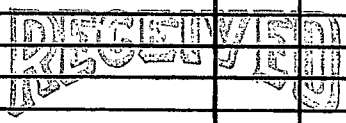


DEC 08 1986

Department of Natural Resources
Bureau of Land & Water Resources

If well telescopes please sketch and show depths.

GROUND LEVEL

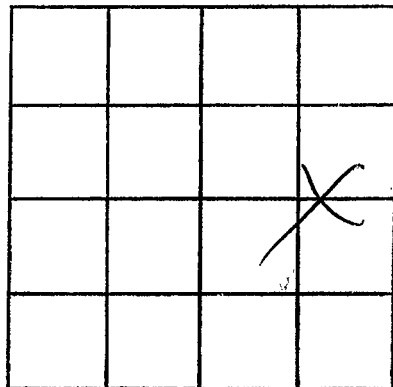

SECTION 29

Please indicate well location X.

ADDITIONAL INFORMATION

If more than one screen,
show locations of each on sketch.