

PIKE
E
2062

MISSISSIPPI DEPARTMENT OF NATURAL RESOURCES
Bureau of Land and Water Resources
Southport Mall
P.O. Box 10631
Jackson, Mississippi 39209
WATER WELL DRILLERS LOG

7-28
date well completed

1986 Fitzgerald Sew.
firm name

Pike
county well located

LANDOWNER:

Louise Bealock
R.R. #1 McComb, Ms.
(mailing address)

description of formations encountered

from

to

Red clay	0	20
Red sand	20	80
Coarse sand & gravel	80	98

WELL LOCATION:


sec. 7 T 3 N R 8 E
S W
1 miles E of McComb-
(distance) (direction) (nearest town)

WELL PURPOSE:

Home
(home, irrigation, municipal, industrial)

WELL COMPLETION DATA:

- (1) diameter (inches) 4
- (2) total depth (feet) 98
- (3) static water level (feet) 60 below above top of ground.
- (4) casing PVC 88, (material) (depth)
4 (size) if telescope see back.
- (5) screen 10, 88 (length) (depth to top)
4 (size) PVC (material)
- (6) pump 1/2 10 (HP) (yield gpm)
Elec (type power)
- (7) electric log No (yes or no)
(organization running log)
- (8) how well bottom plugged Sealed

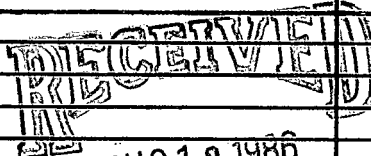


DRILLERS REMARKS:

Department of Natural Resources
Bureau of Land & Water Resources

If well telescopes please sketch and show depths.

GROUND LEVEL

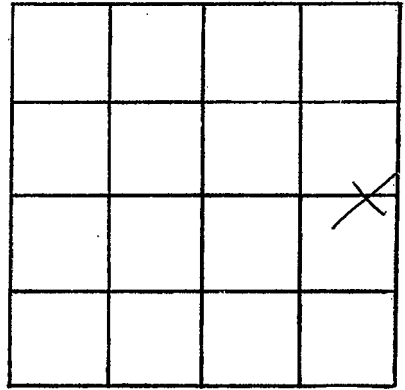

SECTION 2

Please indicate well location X.

ADDITIONAL INFORMATION

If more than one screen, show locations of each on sketch.