

MISSISSIPPI DEPARTMENT OF NATURAL RESOURCES

Bureau of Land and Water Resources

Southport Mall

P.O. Box 10631

Jackson, Mississippi 39209

WATER WELL DRILLERS LOG

PIKE
E 2064

9-11 1986
date well completed

Fitzgerald Well Serv
firm name

Pike
county well located

LANDOWNER:
Billy Boyce
R.R. 1, McComb, Ms.
(mailing address)

description of formations encountered	from	to
<u>Red clay</u>	<u>0</u>	<u>20</u>
<u>Red sand</u>	<u>20</u>	<u>95</u>
<u>white chalk</u>	<u>95</u>	<u>180</u>
<u>fine sand</u>	<u>180</u>	<u>195</u>
<u>Coarse sand & gravel</u>	<u>195</u>	<u>210</u>

WELL LOCATION:
sec. 14 T 3 N R 8 E
S W
6 miles E of McComb
(distance) (direction) (nearest town)

WELL PURPOSE: Home
(home, irrigation, municipal, industrial)

WELL COMPLETION DATA:

(1) diameter (inches) 4

(2) total depth (feet) 210

(3) static water level (feet) 93 below top of ground.

(4) casing POC 200
(material) (depth)
4 if telescope see back.
(size)

(5) screen 10 200
(length) (depth to top)
4 POC
(size) (material)

(6) pump 1/2 10
(HP) (yield gpm)
Electric
(type power)

(7) electric log No
(yes or no)
Electric
(organization running log)

(8) how well bottom plugged Good

RECEIVED


OCT 14 1986

Department of Natural Resources
Bureau of Land & Water Resources

DRILLERS REMARKS:

If well telescopes please sketch and show depths.

GROUND LEVEL

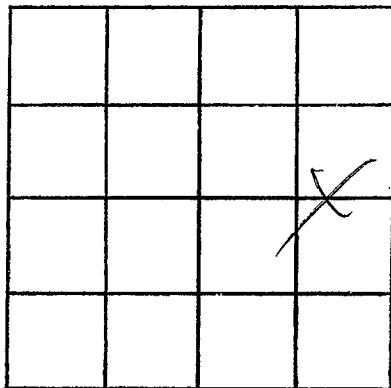

SECTION 14

Please indicate well location X.

ADDITIONAL INFORMATION

If more than one screen, show locations of each on sketch.