

MISSISSIPPI DEPARTMENT OF NATURAL RESOURCES

Bureau of Land and Water Resources

P.O. Box 10631

Jackson, Mississippi 39209

WATER WELL DRILLERS LOG

COUNTY WELL LOCATED <i>Perche</i>	
WELL NUMBER E	CODED
DATE WELL COMPLETED <i>10/5-87</i>	

PERMIT NUMBER
NAME OF DRILLING FIRM FITZGERALD
<i>well service</i>

NAME & MAILING ADDRESS OF LANDOWNER <i>Edgar Fowler</i>			
<i>Ave A, Momb, MS</i>			
WELL LOCATION: SEC	TOWNSHIP	RANGE	
<i>7</i>	<i>3</i>	<i>8</i>	<i>8</i> ^N ^E _W
DISTANCE	DIRECTION	NEAREST TOWN	
<i>1 1/4</i> Miles	<i>EAST</i> of	<i>Momb</i>	
OTHER LANDMARK			
WELL PURPOSE: Home, Irrigation, Municipal, Industrial, Fish Pond, etc. <i>Home & Heat Pump</i>			

PUMP DATA		
PUMP TYPE (Circle One): Submersible, Turbine, Jet, Flowing Well, Other (Describe) _____		
POWER TYPE (Circle One): Electric, Tractor, Diesel, Gasoline, Butane, Other (Describe) _____		
Pump Capacity (GPM) <i>15</i>	No. of Stages <i>15</i>	Setting Depth <i>75</i> FT.
PUMP TEST		
Well yielded <i>15</i> GPM with a drawdown of <i>5</i> ft. after <i>1</i> hours of pumping		

WELL DATA		
Well Depth <i>110</i>	Casing Diameter (In.) <i>4</i>	Casing Length (Ft.) <i>100</i>
Type of Casing <i>PVC</i>	Hole Depth <i>110</i>	Depth to Static Water Level <i>35</i>
TYPE OF COMPLETION: (Circle One or More): Gravel Packed, Underreamed, Telescoped, Natural Development, Open Hole, Other (Describe) _____		
Top of Lap Pipe or Reduction in Casing FEET <input type="checkbox"/> IF TELESCOPED OR MORE THAN ONE SCREEN: USE BACK PAGE		

LOG DATA	
TYPE OF LOG RUN (Circle One): Electric, Gamma Ray, Density, Sonic, Neutron, Other (Describe) _____	
Name of Organization Running Log	

SCREEN DATA		
Diameter - Inches <i>4</i>	Length - Feet <i>10</i>	Slot Size - Inches <i>.014</i>
Screen Type <i>PVC</i>		Depth to Bottom - Feet <i>110</i>


GEOLOGIC DATA (Office Use Only)			
Surface Elev.	Geologic Unit	Unit Thickness	Depth to Top
Subs. SWL	Date	Analysis	Aquifer Test
Driller's Remarks			

DESCRIPTION OF FORMATIONS ENCOUNTERED	FROM	TO
<i>Red clay</i>	<i>0</i>	<i>20</i>
<i>Red sand</i>	<i>20</i>	<i>94</i>
<i>Coarse sand & gravel</i>	<i>94</i>	<i>110</i>

FORMATIONS (Continued)	FROM	TO
RECEIVED		
OCT 27 1987		
Department of Natural Resources Bureau of Land & Water Resources		
IF MORE SPACE IS NEEDED, USE BACK		

If well telescopes please sketch and show depths.

GROUND LEVEL

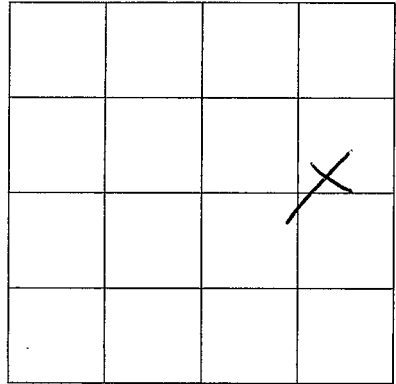

SECTION 7

Please indicate well location X.

ADDITIONAL INFORMATION

If more than one screen,
show location of each on sketch.