

MISSISSIPPI DEPARTMENT OF NATURAL RESOURCES

Bureau of Land and Water Resources

Southport Mall

P.O. Box 10631

Jackson, Mississippi 39209

WATER WELL DRILLERS LOG

PIKE
E 2068

Feb 23 1987  
date well completed

John Fitzgerald Well Serv  
firm name

Pike  
county well located

LANDOWNER:	description of formations encountered	from	to
Susie McCoy Rt 4, McComb, Ms. (mailing address)			
WELL LOCATION:			
sec. 28 T 3 N R 8 E S W			
3 miles E of McComb (distance) (direction) (nearest town)			
WELL PURPOSE: Home (home, irrigation, municipal, industrial)			
WELL COMPLETION DATA:			
(1) diameter (inches) 4			
(2) total depth (feet) 96			
(3) static water level (feet) 54 below top of ground. above			
(4) casing PVC, 86 (material) (depth)			
4 if telescope see back. (size)			
(5) screen 10, 86 (length) (depth to top)			
4, PVC (size) (material)			
(6) pump 1/2, 10 (HP) (yield gpm)			
Electric (type power)			
(7) electric log No (yes or no)			
(organization running log)			
(8) how well bottom plugged Sand & silt			

RECEIVED


MAR 20 1987

Department of Natural Resources  
Bureau of Land & Water Resources

DRILLERS REMARKS:

If well telescopes please sketch and show depths.

GROUND LEVEL

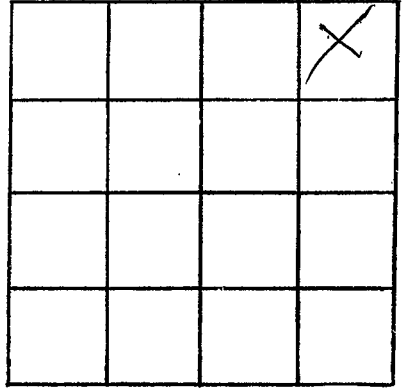

SECTION 28

Please indicate well location X.

ADDITIONAL INFORMATION

If more than one screen, show locations of each on sketch.