

# MISSISSIPPI DEPARTMENT OF NATURAL RESOURCES

## Bureau of Land and Water Resources

P.O. Box 10631  
Jackson, Mississippi 39209  
WATER WELL DRILLERS LOG

COUNTY WELL LOCATED <i>Pike</i>	
WELL NUMBER <i>E</i>	CODED
DATE WELL COMPLETED <i>2072</i> <i>NOV 14 88</i>	

PERMIT NUMBER
NAME OF DRILLING FIRM <i>Fitzgerald Well Serv</i>

NAME & MAILING ADDRESS OF LANDOWNER <i>Dale Dunaway</i>		
<i>RB. 1, McComb, MS</i>		
WELL LOCATION: SEC <i>1</i> TOWNSHIP <i>3</i> RANGE <i>8</i>		
<i>6</i> Miles <i>E</i> of <i>McComb</i>		
DISTANCE _____ DIRECTION _____ NEAREST TOWN _____		
OTHER LANDMARK		
WELL PURPOSE: Home, Irrigation, Municipal, Industrial, Fish Pond, etc. <i>Home</i>		

PUMP DATA		
PUMP TYPE (Circle One): <input checked="" type="checkbox"/> Submersible, <input type="checkbox"/> Turbine, <input type="checkbox"/> Jet <input type="checkbox"/> Flowing Well, Other (Describe) _____		
POWER TYPE (Circle One): <input checked="" type="checkbox"/> Electric, <input type="checkbox"/> Tractor, <input type="checkbox"/> Diesel, <input type="checkbox"/> Gasoline, <input type="checkbox"/> Butane, Other (Describe) _____		
Pump Capacity (GPM) <i>10</i>	No. of Stages <i>9</i>	Setting Depth <i>25</i> FT.
PUMP TEST		
Well yielded <i>10</i> GPM with a drawdown of <i>2</i> ft. after <i>1</i> hours of pumping		

WELL DATA		
Well Depth <i>52</i>	Casing Diameter (In.) <i>4</i>	Casing Length (Ft.) <i>42</i>
Type of Casing <i>PLC</i>	Hole Depth <i>52</i>	Depth to Static Water Level <i>10</i>
TYPE OF COMPLETION: (Circle One or More): <input checked="" type="checkbox"/> Gravel Packed, <input type="checkbox"/> Underreamed, <input type="checkbox"/> Telescoped, <input type="checkbox"/> Natural Development, <input type="checkbox"/> Open Hole, <input type="checkbox"/> Other		
Top of Lap Pipe or Reduction in Casing FEET _____ <input type="checkbox"/> IF TELESCOPED OR MORE THAN ONE SCREEN: USE BACK PAGE		

LOG DATA	
TYPE OF LOG RUN (Circle One): <input type="checkbox"/> Electric, <input type="checkbox"/> Gamma Ray, <input type="checkbox"/> Density, <input type="checkbox"/> Sonic, <input checked="" type="checkbox"/> Neutron, Other (Describe) _____	
Name of Organization Running Log	


SCREEN DATA		
Diameter - Inches <i>4</i>	Length - Feet <i>10</i>	Slot Size - Inches <i>10/14</i>
Screen Type <i>PLC</i>		Depth to Bottom - Feet <i>52</i>

GEOLOGIC DATA (Office Use Only)			
Surface Elev.	Geologic Unit	Unit Thickness	Depth to Top
Subs. SWL	Date	Analysis	Aquifer Test
Driller's Remarks			
<b>RECEIVED</b>			

DESCRIPTION OF FORMATIONS ENCOUNTERED	FROM	TO	FORMATIONS (Continued)	FROM	TO
<i>Red clay</i>	<i>0</i>	<i>5</i>	<b>JAN 03 1989</b>  <b>Department of Natural Resources</b> <b>Bureau of Land &amp; Water Resources</b>		
<i>Red sand</i>	<i>5</i>	<i>40</i>			
<i>Coarse sand &amp; gravel</i>	<i>40</i>	<i>52</i>			
IF MORE SPACE IS NEEDED, USE BACK					

If well telescopes please sketch and show depths.

GROUND LEVEL

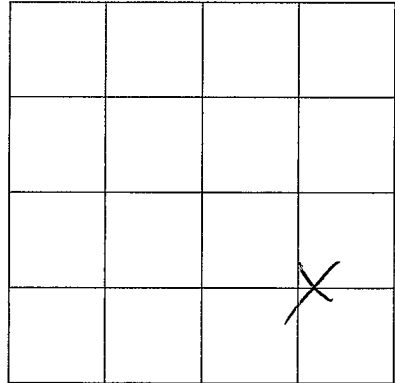

SECTION   1  

Please indicate well location X.

ADDITIONAL INFORMATION

If more than one screen,  
show location of each on sketch.