

MISSISSIPPI DEPARTMENT OF NATURAL RESOURCES
 Bureau of Land and Water Resources
 Southport Mall
 P.O. Box 10631
 Jackson, Mississippi 39209
WATER WELL DRILLERS LOG

PIKE
E2080

6-5 19 90 Fitzgerald Well Sew Pike
 date well completed firm name county well located

LANDOWNER:
Vertile
Vertile Page -
R.R. McComb MS -
 (mailing address)

description of formations encountered	from	to
<u>Red Clay</u>	<u>0</u>	<u>20</u>
<u>Red Sand</u>	<u>20</u>	<u>90</u>
<u>Coarse Sand & gravel</u>	<u>90</u>	<u>143</u>

WELL LOCATION:
 sec. 21 T. 3 N R. 8 E
 S W
4 miles E of McComb
 (distance) (direction) (nearest town)

WELL PURPOSE: Home
 (home, irrigation, municipal, industrial)

- WELL COMPLETION DATA:**
- (1) diameter (inches) 4
 - (2) total depth (feet) 143
 - (3) static water level (feet) 100 below above top of ground.
 - (4) casing PVC, 133,
 (material) (depth)
4 if telescope see back.
 (size)
 - (5) screen 10, 133
 (length) (depth to top)
4, PVC
 (size) (material)
 - (6) pump 1/2 10
 (HP) (yield gpm)
elec
 (type power)
 - (7) electric log no
 (yes or no)
Electric
 (organization running log)
 - (8) how well bottom plugged Sand Seal

RECEIVED


JUN 28 1990

Department of Natural Resources
 Bureau of Land & Water Resources

DRILLERS REMARKS:

If well telescopes please sketch and show depths.

GROUND LEVEL

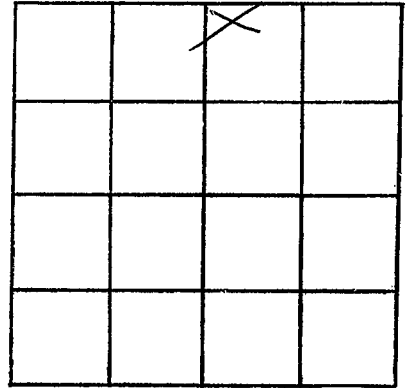

SECTION 21

Please indicate well location X.

ADDITIONAL INFORMATION

If more than one screen,
show locations of each on sketch.