

**MISSISSIPPI DEPARTMENT OF NATURAL RESOURCES**  
 Bureau of Land and Water Resources  
 Southport Mall  
 P.O. Box 10631  
 Jackson, Mississippi 39209  
**WATER WELL DRILLERS LOG**

PIKE  
E 2081

July 5 1990 F. G. Gaudreault Inc. Pike  
 date well completed firm name county well located

LANDOWNER:	description of formations encountered	from	to
<u>Jerry Dillmore</u> <u>R.R. McComb, ms.</u> (mailing address)	<u>Red Clay</u> <u>Red sand</u> <u>Coarse sand &amp; gravel</u>	<u>0</u> <u>20</u> <u>107</u>	<u>20</u> <u>107</u> <u>122</u>
<b>WELL LOCATION:</b>			
sec <u>25</u> T <u>3</u> N R <u>8</u> E S W			
<u>6</u> miles <u>E</u> of <u>McComb</u> (distance) (direction) (nearest town)			
<b>WELL PURPOSE:</b> <u>Home</u> (home, irrigation, municipal, industrial)			
<b>WELL COMPLETION DATA:</b>			
(1) diameter (inches) <u>4</u>			
(2) total depth (feet) <u>122</u>			
(3) static water level (feet) <u>80</u> below above top of ground.			
(4) casing <u>PVC 112</u> , (material) (depth) <u>4</u> If telescope see back. (size)			
(5) screen <u>10</u> , <u>112</u> (length) (depth to top)			
<u>4</u> , <u>PVC</u> (size) (material)			
(6) pump <u>1/2</u> , <u>10</u> (HP) (yield gpm)			
<u>Electric</u> (type power)			
(7) electric log <u>No</u> (yes or no)			
<u>None</u> (organization running log)			
(8) how well bottom plugged <u>Sand Shale</u>			

**RECEIVED**


AUG 17 1990

Department of Natural Resources  
 Bureau of Land & Water Resources

DRILLERS REMARKS:

If well telescopes please sketch and show depths.

GROUND LEVEL

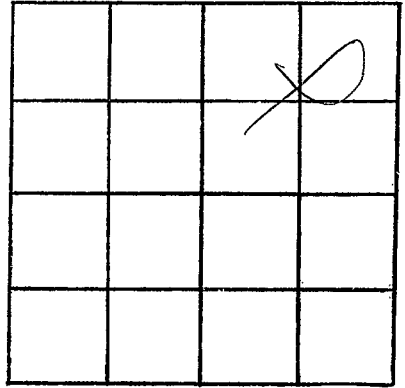

SECTION 25

Please indicate well location X.

ADDITIONAL INFORMATION

If more than one screen,  
show locations of each on sketch.