

MISSISSIPPI DEPARTMENT OF ENVIRONMENTAL QUALITY

Office of Land and Water Resources

P. O. Box 10631
Jackson, MS 39289-0631
WATER WELL DRILLERS LOG

COUNTY WELL LOCATED <i>PIKE</i>	
WELL NUMBER E	CODED
DATE WELL COMPLETED <i>2087</i> APR 23 93	

PERMIT NUMBER
NAME OF DRILLING FIRM <i>F. P. GERALD Well Serv</i>

NAME & MAILING ADDRESS OF LANDOWNER <i>James Torrey</i>		
<i>RR. 1 McComb MS</i>		
WELL LOCATION:	SEC <u>2</u>	TOWNSHIP <u>3</u> N <u>8</u> E W
DISTANCE <u>6</u> Miles	DIRECTION <u>E</u>	NEAREST TOWN <u>McComb</u>
OTHER LANDMARK		
WELL PURPOSE: Home, Irrigation, Municipal, Industrial, Fish Pond, etc. <i>Home</i>		

PUMP DATA		
PUMP TYPE (Circle One): <input checked="" type="checkbox"/> Submersible, Turbine, Jet, Flowing Well, Other (Describe)		
POWER TYPE (Circle One): <input checked="" type="checkbox"/> Electric, Tractor, Diesel, Gasoline, Butane, Other (Describe) <u>H/P</u>		
Pump Capacity (GPM) <u>15</u>	No. of Stages <u>10</u>	Setting Depth <u> </u> FT.
PUMP TEST		
Well yielded <u>25</u> GPM with a drawdown of <u>1</u> ft. after <u>1</u> hours of pumping		

WELL DATA		
Well Depth <u>165</u>	Casing Diameter (In.) <u>4</u>	Casing Length (Ft.) <u>155</u>
Type of Casing <i>PVC</i>	Hole Depth <u>165</u>	Depth to Static Water Level <u>100</u>

LOG DATA	
TYPE OF LOG RUN (Circle One): Electric, Gamma Ray, Density, Sonic, <input checked="" type="checkbox"/> No Log-Run, Neutron, Other (Describe)	
Name of Organization Running Log	

TYPE OF COMPLETION: (Circle One or More): <input checked="" type="checkbox"/> Gravel Packed, Underreamed, Telescoped, Natural Development, Open Hole, Other (Describe)	
---	--

GEOLOGIC DATA (Office Use Only)			
Surface Elev.	Geologic Unit	Unit Thickness	Depth to Top
Subs. SWL	Date	Analysis	Aquifer Test

WELL GROUTED TO A DEPTH OF <u>10</u> FEET
Type Grout (circle one): Cement, Bentonite, or Mix

Driller's Remarks

SCREEN DATA		
Diameter - Inches <u>4</u>	Length - Feet <u>10</u>	Slot Size - Inches <u>10/4</u>
Screen Type <i>PVC</i>	Depth to Bottom - Feet	

DESCRIPTION OF FORMATIONS ENCOUNTERED	FROM	TO	FORMATIONS (Continued)	FROM	TO
<i>Red Clay</i>	<u>0</u>	<u>20</u>			
<i>Red Sand</i>	<u>20</u>	<u>90</u>			
<i>Five sand</i>	<u>90</u>	<u>150</u>			
<i>Course sand</i>	<u>150</u>	<u>165</u>			

RECEIVED


JUN 25 1993

Dept. of Environmental Quality
Office of Land & Water Resources

IF MORE SPACE IS NEEDED, USE BACK

If well telescopes please sketch and show depths.

GROUND LEVEL

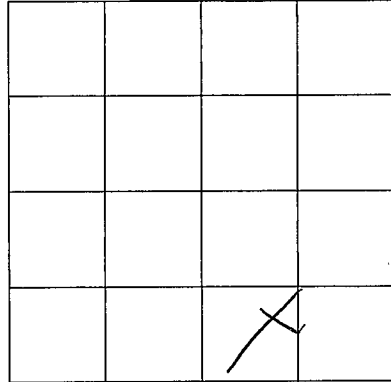

SECTION 2

Please indicate well location X.

ADDITIONAL INFORMATION

If more than one screen,
show location of each on sketch.