

**MISSISSIPPI DEPARTMENT OF ENVIRONMENTAL QUALITY**

Office of Land and Water Resources

P. O. Box 10631  
Jackson, MS 39289-0631  
**WATER WELL DRILLERS LOG**

COUNTY WELL LOCATED <i>Okla</i>	
WELL NUMBER <i>E</i>	CODED
DATE WELL COMPLETED <i>2092</i> <i>Oct 11-94</i>	

PERMIT NUMBER
NAME OF DRILLING FIRM <i>Fitzgerald Well Serv</i>

NAME & MAILING ADDRESS OF LANDOWNER <i>Dennis White</i> <i>RR. McComb MS</i>			
WELL LOCATION:	SEC <i>5</i>	TOWNSHIP <i>3</i>	RANGE <i>8</i>
		<i>N</i>	<i>E</i>
		<i>S</i>	<i>W</i>
DISTANCE <i>1</i> Miles	DIRECTION <i>E</i>	NEAREST TOWN <i>McComb</i>	
OTHER LANDMARK			
WELL PURPOSE: Home, Irrigation, Municipal, Industrial, Fish Pond, etc. <i>Home</i>			

PUMP DATA			
PUMP TYPE (Circle One): <input checked="" type="radio"/> Submersible, <input type="radio"/> Turbine, <input type="radio"/> Jet <input type="radio"/> Flowing Well, Other (Describe) _____			
POWER TYPE (Circle One): <input checked="" type="radio"/> Electric, <input type="radio"/> Tractor, <input type="radio"/> Diesel, <input type="radio"/> Gasoline, <input type="radio"/> Butane, Other (Describe) _____ H/P <i>V2</i>			
Pump Capacity (GPM) <i>10</i>	No. of Stages <i>8</i>	Setting Depth <i>95</i> FT.	
PUMP TEST			
Well yielded <i>30</i> GPM with a drawdown of <i>2</i> ft. after <i>2</i> hours of pumping			

WELL DATA		
Well Depth <i>104</i>	Casing Diameter (In.) <i>4</i>	Casing Length (Ft.) <i>94</i>
Type of Casing <i>PSC</i>	Hole Depth <i>104</i>	Depth to Static Water Level <i>75</i>

LOG DATA	
TYPE OF LOG RUN (Circle One): <input checked="" type="radio"/> No Log Run, <input type="radio"/> Electric, <input type="radio"/> Gamma Ray, <input type="radio"/> Density, <input type="radio"/> Sonic, <input type="radio"/> Neutron, Other (Describe) _____	
Name of Organization Running Log	

TYPE OF COMPETITION: (Circle One or More):  
 Gravel Packed,  Underreamed,  Telescoped,  
 Natural Development,  Open Hole,  Other

WELL GROUTED TO A DEPTH OF *10* FEET  
Type Grout (circle one): Cement, Bentonite,  Mix

GEOLOGIC DATA (Office Use Only)			
Surface Elev.	Geologic Unit	Unit Thickness	Depth to Top
Subs. SWL	Date	Analysis	Aquifer Test
Driller's Remarks			
Top of Lap Pipe or Reduction in Casing			
FEET		IF TELESCOPED OR MORE THAN ONE SCREEN: USE BACK PAGE	


SCREEN DATA		
Diameter - Inches <i>4</i>	Length - Feet <i>10</i>	Slot Size - Inches <i>.010</i>
Screen Type <i>PSC</i>	Depth to Bottom - Feet <i>104</i>	

DESCRIPTION OF FORMATIONS ENCOUNTERED	FROM	TO
<i>Red Clay</i>	<i>0</i>	<i>20</i>
<i>Red Sand</i>	<i>20</i>	<i>84</i>
<i>Coarse Sand &amp; Gravel</i>	<i>84</i>	<i>104</i>

FORMATIONS (Continued)	FROM	TO
<b>RECEIVED</b>		
<b>OCT 14 1994</b>		
Dept. of Environmental Quality Office of Land & Water Resources		
IF MORE SPACE IS NEEDED, USE BACK		

If well telescopes please sketch and show depths.

GROUND LEVEL

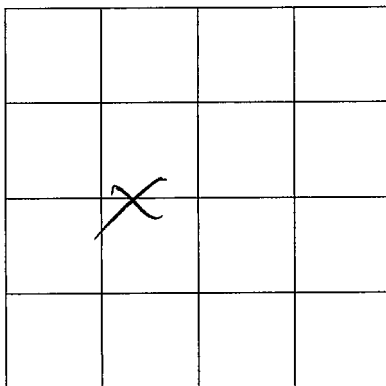

SECTION 5

Please indicate well location X.

ADDITIONAL INFORMATION

If more than one screen, show location of each on sketch.