

MISSISSIPPI DEPARTMENT OF ENVIRONMENTAL QUALITY

Office of Land and Water Resources

P. O. Box 10631
Jackson, MS 39289-0631
WATER WELL DRILLERS LOG

COUNTY WELL LOCATED Pike	
WELL NUMBER E	CODED
DATE WELL COMPLETED 2023 7-28-95	

PERMIT NUMBER
NAME OF DRILLING FIRM Pi Regerand well service

NAME & MAILING ADDRESS OF LANDOWNER Beatrice Coarum			
RR McComb			
WELL LOCATION:	SEC 10	TOWNSHIP 3	RANGE 8
		N	E
		S	W
DISTANCE 5 Miles	DIRECTION E	NEAREST TOWN McComb	
OTHER LANDMARK			
WELL PURPOSE (Home, Irrigation, Municipal, Industrial, Fish Pond, etc.) Home			

PUMP DATA		
PUMP TYPE (Circle One): <u>Submersible</u> , Turbine, Jet, Flowing Well, Other (Describe)		
POWER TYPE (Circle One): <u>Electric</u> , Tractor, Diesel, Gasoline, Butane, Other (Describe) H/P 1/2		
Pump Capacity (GPM) 10	No. of Stages 8	Setting Depth 45 FT.
PUMP TEST		
Well yielded 20 GPM with a drawdown of 1 ft. after 1 hours of pumping		

WELL DATA		
Well Depth 127'	Casing Diameter (In.) 4"	Casing Length (Ft.) 117'
Type of Casing PVC	Hole Depth 127'	Depth to Static Water Level 14"

LOG DATA	
TYPE OF LOG RUN (Circle One): Electric, Gamma Ray, Density, Sonic, Neutron, Other (Describe) <u>No Log Run</u>	
Name of Organization Running Log	

TYPE OF COMPLETION: (Circle One or More): <u>Gravel Packed</u> , Underreamed, Telescoped, Natural Development, Open Hole, Other (Describe)	
---	--

GEOLOGIC DATA (Office Use Only)			
Surface Elev.	Geologic Unit	Unit Thickness	Depth to Top
Subs. SWL	Date	Analysis	Aquifer Test

WELL GROUTED TO A DEPTH OF 10 FEET
Type Grout (circle one): Cement, Bentonite, <u>or Mix</u>

SCREEN DATA		
Diameter - Inches 4"	Length - Feet 10"	Slot Size - Inches .012
Screen Type PVC		Depth to Bottom - Feet 127'

Driller's Remarks
RECEIVED
SEP 06 1995


DESCRIPTION OF FORMATIONS ENCOUNTERED	FROM	TO
Top Soil	0	5
Sand + gravel	5	30
red clay	30	40
Sand + gravel	40	70
red clay	70	110
Course Sand	110	127

FORMATIONS (Continued)	FROM	TO
Dept. of Environmental Quality		
Office of Land & Water Resources		

IF MORE SPACE IS NEEDED, USE BACK

If well telescopes please
sketch and show depths.

GROUND LEVEL

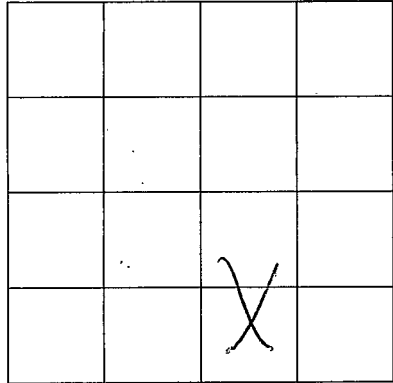

SECTION _____

Please indicate well location X.

ADDITIONAL INFORMATION

If more than one screen,
show location of each on sketch.