

MISSISSIPPI DEPARTMENT OF ENVIRONMENTAL QUALITY

Office of Land and Water Resources

P. O. Box 10631
Jackson, MS 39289-0631
WATER WELL DRILLERS LOG

COUNTY WELL LOCATED
PIKE

WELL NUMBER E 2105 CODED

DATE WELL COMPLETED
9-13-97

PERMIT NUMBER
0-207

NAME OF DRILLING FIRM
REEVES WELL SER.

NAME & MAILING ADDRESS OF LANDOWNER
CLINTON WARNER
CLINTON WARNER
DUNAWAY Rd.

M. G. Comb MISS.

WELL LOCATION: SEC 32 TOWNSHIP 3 RANGE 8
S W

DISTANCE 3 Miles DIRECTION NE of NEAREST TOWN MAGNOLIA

OTHER LANDMARK

WELL PURPOSE: Home, Irrigation, Municipal, Industrial, Fish Pond, etc.
HOME

PUMP DATA

PUMP TYPE (Circle One):
Submersible, Turbine, Jet, Flowing Well,
Other (Describe)

POWER TYPE (Circle One):
Electric, Tractor, Diesel, Gasoline, Butane,
Other (Describe) H/P

Pump Capacity (GPM) / No. of Stages / Setting Depth FT.

PUMP TEST
Well yielded 60 GPM with
a drawdown of 0 ft.
after 1 hours of pumping

WELL DATA

Well Depth 120' Casing Diameter (In.) 4" Casing Length (Ft.) 20'

Type of Casing PVC Hole Depth 120' Depth to Static Water Level 85'

TYPE OF COMPLETION: (Circle One or More):
Gravel Packed, Underreamed, Telescoped,
Natural Development, Open Hole, Other
(Describe) 10 GAL. SAND

WELL GROUTED TO A DEPTH OF 10 FEET
Type Grout (circle one): Cement, Bentonite, or Mix

LOG DATA

TYPE OF LOG RUN (Circle One):
No Log Run, Electric, Gamma Ray, Density, Sonic, Neutron,
Other (Describe)

Name of Organization Running Log

SCREEN DATA

Diameter - Inches 4" Length - Feet 10' Slot Size - Inches 10 THOUS.

Screen Type PVC Depth to Bottom - Feet 120'

GEOLOGIC DATA (Office Use Only)

Surface Elev.	Geologic Unit	Unit Thickness	Depth to Top
Subs. SWL	Date	Analysis	Aquifer Test

Driller's Remarks

Top of Lap Pipe or Reduction in Casing

IF TELESCOPED OR MORE THAN ONE SCREEN USE BACK PAGE

DESCRIPTION OF FORMATIONS ENCOUNTERED	FROM	TO
<u>CLAY</u>	<u>0</u>	<u>15</u>
<u>SAND</u>	<u>15</u>	<u>50</u>
<u>SAND & GRAVEL</u>	<u>50</u>	<u>120</u>

FORMATIONS (Continued) FROM TO


SFP 23 1997

Dept. of Environmental Quality
Office of Land & Water Resources

IF MORE SPACE IS NEEDED, USE BACK

If well telescopes please
sketch and show depths.

GROUND LEVEL

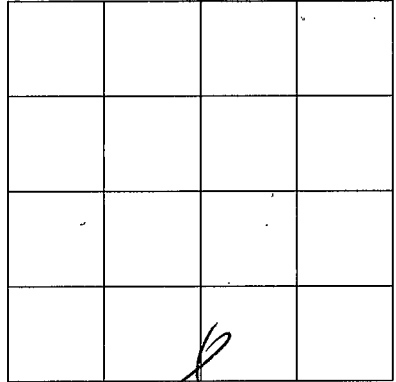

SECTION 32

Please indicate well location X.

ADDITIONAL INFORMATION

If more than one screen,
show location of each on sketch.