

MISSISSIPPI DEPARTMENT OF ENVIRONMENTAL QUALITY

Office of Land and Water Resources

P. O. Box 10631

Jackson, MS 39289-0631

WATER WELL DRILLERS LOG

COUNTY WELL LOCATED
AIKE

WELL NUMBER
E 2108

DATE WELL COMPLETED
12-30-97

PERMIT NUMBER
0-287

NAME OF DRILLING FIRM
Reever Well Ser.

NAME & MAILING ADDRESS OF LANDOWNER
Jerry Fortenberry

WELL LOCATION: SEC **16** TOWNSHIP **30 S** RANGE **8 W**

DISTANCE **5** Miles DIRECTION **E** of NEAREST TOWN **M9 Comb**

OTHER LANDMARK

WELL PURPOSE: Home, Irrigation, Municipal, Industrial, Fish Pond, etc.
HOME

PUMP DATA

PUMP TYPE (Circle One): Submersible Turbine, Jet, Flowing Well, Other (Describe)

POWER TYPE (Circle One): Electric Tractor, Diesel, Gasoline, Butane, Other (Describe) H/P

Pump Capacity (GPM) **10** No. of Stages **8** Setting Depth **120** FT.

PUMP TEST
Well yielded **50** GPM with a drawdown of **0** ft. after **1** hours of pumping

WELL DATA

Well Depth 130'	Casing Diameter (In.) 4"	Casing Length (Ft.) 20'
Type of Casing PVC	Hole Depth 130'	Depth to Static Water Level 90'

LOG DATA

TYPE OF LOG RUN (Circle One): No Log Run, Electric, Gamma Ray, Density, Sonic, Neutron, Other (Describe)

Name of Organization Running Log

TYPE OF COMPLETION: (Circle One or More): Gravel Packed, Underreamed, Telescoped, Natural Development, Open Hole, Other (Describe) **10 gal sand**

WELL GROUTED TO A DEPTH OF **10** FEET
Type Grout (circle one): Cement, Bentonite, or Mix

GEOLOGIC DATA (Office Use Only)

Surface Elev.	Geologic Unit	Unit Thickness	Depth to Top
Subs. SWL	Date	Analysis	Aquifer Test

SCREEN DATA

Diameter - Inches 4"	Length - Feet 10'	Slot Size - Inches 10 THDS.
Screen Type PVC	Depth to Bottom - Feet 130'	

Driller's Remarks

Top of Lap Pipe or Reduction in Casing

FEET IF TELESKOPED OR MORE THAN ONE SCREEN: USE BACK PAGE


DESCRIPTION OF FORMATIONS ENCOUNTERED	FROM	TO	FORMATIONS (Continued)	FROM	TO
Clay	0	40			
Sand & gravel	40	90			
clay	90	110			
Sand & pea gravel	110	130			

06 23 98A09:37 RCVD

IF MORE SPACE IS NEEDED, USE BACK

If well telescopes please
sketch and show depths.

GROUND LEVEL

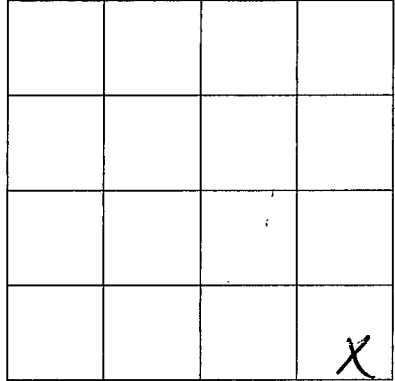

SECTION 16

Please indicate well location X.

ADDITIONAL INFORMATION

If more than one screen,
show location of each on sketch.
