

MISSISSIPPI DEPARTMENT OF ENVIRONMENTAL QUALITY

Office of Land and Water Resources

P. O. Box 10631
Jackson, MS 39289-0631
WATER WELL DRILLERS LOG

COUNTY WELL LOCATED
Pike

WELL NUMBER E-2125 CODED

DATE WELL COMPLETED
3-27-01

PERMIT NUMBER
0-621

NAME OF DRILLING FIRM
David Boone

NAME & MAILING ADDRESS OF LANDOWNER
Don Lindley
1114 Merle Dr.
McComb MS

WELL LOCATION: SEC. 25 TOWNSHIP 3 RANGE N 6 E

DISTANCE 5 1/2 Miles DIRECTION JE of NEAREST TOWN McComb

OTHER LANDMARK

WELL PURPOSE Home Irrigation, Municipal, Industrial, Fish Pond, etc.

PUMP DATA

PUMP TYPE (Circle One):
 Submersible, Turbine, Jet, Flowing Well,
Other (Describe)

POWER TYPE (Circle One):
 Electric, Tractor, Diesel, Gasoline, Butane,
Other (Describe) H/P

Pump Capacity (GPM) 12 No. of Stages 1 Setting Depth 125 FT.

PUMP TEST

Well yielded 16 GPM with a drawdown of 15 ft. after 12 hours of pumping

WELL DATA

Well Depth 180 Casing Diameter (In.) 4" Casing Length (Ft.) 160

Type of Casing PVC Hole Depth 180 Depth to Static Water Level 90'

TYPE OF COMPLETION: (Circle One or More):
 Gravel Packed, Underreamed, Telescoped,
 Natural Development, Open Hole, Other
(Describe)

WELL GROUTED TO A DEPTH OF 10 FEET
Type Grout (circle one): Cement, Bentonite, or Mix

LOG DATA

TYPE OF LOG RUN (Circle One):
 No Log Run, Electric, Gamma-Ray, Density, Sonic, Neutron,
Other (Describe)

Name of Organization Running Log

SCREEN DATA

Diameter - Inches 4" Length - Feet 20 Slot Size - Inches 008

Screen Type PVC Sch. 40 Depth to Bottom - Feet 0

GEOLOGIC DATA (Office Use Only)

Surface Elev.	Geologic Unit	Unit Thickness	Depth to Top
Subs. SWL	Date	Analysis	Aquifer Test

Driller's Remarks

Top of Lap Pipe or Reduction in Casing

FEET IF TELESCOPED OR MORE THAN ONE SCREEN: USE BACK PAGE


DESCRIPTION OF FORMATIONS ENCOUNTERED	FROM	TO	FORMATIONS (Continued)	FROM	TO
Clay	0	14			
Sand & Gravel	14	60			
Clay	60	90			
Gravel	90	110			
Clay	110	125			
Sand	125	180			

REC'D AUG 31 2001

IF MORE SPACE IS NEEDED, USE BACK

If well telescopes please sketch and show depths.

GROUND LEVEL

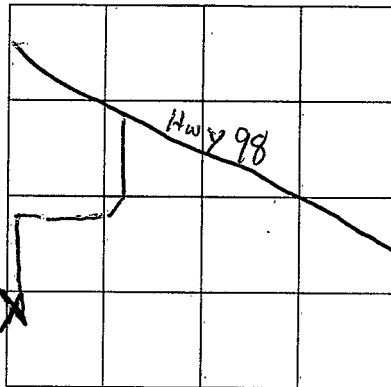

SECTION 25

Please indicate well location X.

ADDITIONAL INFORMATION

If more than one screen, show location of each on sketch.