

MISSISSIPPI DEPARTMENT OF ENVIRONMENTAL QUALITY

Office of Land and Water Resources

P. O. Box 10631
Jackson, MS 39289-0631

WATER WELL DRILLERS LOG

COUNTY WELL LOCATED
Pike

WELL NUMBER 5 CODED

E-2127
DATE WELL COMPLETED
12-7-01

PERMIT NUMBER
079

NAME OF DRILLING FIRM
Reever Well Ser.

NAME & MAILING ADDRESS OF LANDOWNER
Pat Martin

Latitude:
Longitude:

WELL LOCATION. SEC TOWNSHIP RANGE
10 3 N 8 E

DISTANCE DIRECTION NEAREST TOWN
4 Miles E of McComb

OTHER LANDMARK

WELL PURPOSE: Home, Irrigation, Municipal, Industrial, Fish Pond, etc.
Home

PUMP DATA

PUMP TYPE (Circle One):
Submersible Turbine Jet Flowing Well,
Other (Describe)

POWER TYPE (Circle One):
Electric Tractor Diesel Gasoline Butane,
Other (Describe) H/P

DESCRIPTION OF FORMATIONS ENCOUNTERED	FROM	TO
0-20 <u>drift sand</u>	0	20
<u>gravel & sand</u>	20	60
<u>sand & clay</u>	60	70
<u>gravel & sand</u>	70	90

WELL DATA

Well Depth 90' Casing Diameter (In.) 4" Casing Length (Ft.) 20'

Type of Casing Pvc Hole Depth 90' Depth to Static Water Level 70

TYPE OF COMPLETION: (Circle One or More):
Gravel Packed Underreamed Telescoped
Natural Development Open Hole Other
(Describe) 10 gal Sand

WELL GROUTED TO A DEPTH OF 10' FEET
Type Grout (circle one): Cement Bentonite, or Mix

SCREEN DATA

Diameter - Inches 4" Length - Feet 10' Slot Size - Inches 10 slot

Screen Type Pvc Depth to Bottom - Feet 90'

REC'D JAN 03 2002

Top of Lap Pipe or Reduction in Casing
FEET IF TELESCOPED OR MORE THAN ONE SCREEN: USE BACK PAGE

I certify that the well was drilled, constructed and completed in accordance with all applicable Requirements of the Mississippi Department of Environmental Quality and/or the Mississippi Department of Health regulations and state laws.


Jimmy Reever 0-668
Signature of Licensed Driller and License No.

12-7-01
Date

Additional Information Required On Back

If well telescopes please sketch and show depths.

GROUND LEVEL

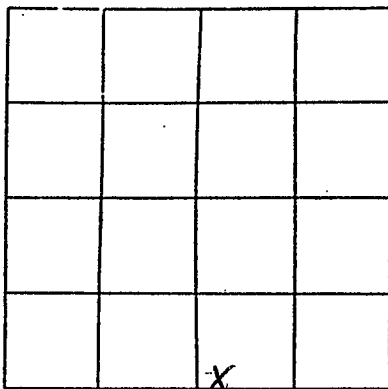

SECTION 10

Please indicate well location X.

Pump Capacity (GPM)	No. of Stages	Setting Depth
<u>10</u>	<u>8</u>	<u>85</u> FT.

PUMP TEST

Well yielded 50 GPM with
 a drawdown of 0 ft.
 after 1 hours of pumping

LOG DATA

TYPE OF LOG RUN (Circle One): No Log Run, Electric, Gamma Ray, Density, Sonic, Neutron, Other (Describe) _____

Name of Organization Running Log _____

GEOLOGIC DATA (Office Use Only)

Surface Elev.	Geologic Unit	Unit Thickness	Depth to Top
Subs. SWL	Date	Analysis	Aquifer Test

Driller's Remarks

If more than one screen, show location of each on sketch.