

MISSISSIPPI DEPARTMENT OF ENVIRONMENTAL QUALITY

Office of Land and Water Resources

P. O. Box 10631  
Jackson, MS 39289-0631  
WATER WELL DRILLERS LOG

COUNTY WELL LOCATED  
Pike

WELL NUMBER  
E-2136

CODED

PERMIT NUMBER

DATE WELL COMPLETED  
2-27-02

NAME OF DRILLING FIRM  
Fitzgerald Well Service

NAME & MAILING ADDRESS OF LANDOWNER  
David Leblanc

Shenwood Dr. McComb, MS

Latitude:

Longitude:

WELL LOCATION: SEC 14 TOWNSHIP 3 RANGE 8 S W

DISTANCE 6 Miles DIRECTION EAST of NEAREST TOWN McComb

OTHER LANDMARK

WELL PURPOSE: Home, Irrigation, Municipal, Industrial, Fish Pond, etc.  
Home

PUMP DATA

PUMP TYPE (Circle One):  
Submersible Turbine, Jet, Flowing Well,  
Other (Describe)

POWER TYPE (Circle One):  
Electric Tractor, Diesel, Gasoline, Butane,  
Other (Describe) H/P 1/2"

DESCRIPTION OF FORMATIONS ENCOUNTERED	FROM	TO
<u>clay</u>	<u>0</u>	<u>40</u>
<u>gravel</u>	<u>40</u>	<u>90</u>
<u>clay</u>	<u>90</u>	<u>100</u>
<u>sand</u>	<u>100</u>	<u>120</u>
<u>clay</u>	<u>120</u>	<u>140</u>
<u>sand</u>	<u>140</u>	<u>170</u>
<u>coarse sand &amp; gravel</u>	<u>170</u>	<u>180</u>

RECEIVED  
MAR 12 2002  
BY: OLWR

Top of Lap Pipe or Reduction in Casing  
FEET IF TELESKOPED OR MORE THAN ONE SCREEN: USE BACK PAGE

WELL DATA

Well Depth 180' Casing Diameter (In.) 4" Casing Length (Ft.) 170'

Type of Casing PVC Hole Depth 180' Depth to Static Water Level 94'

TYPE OF COMPLETION: (Circle One or More):  
Gravel Packed, Underreamed, Telescoped,  
Natural Development, Open Hole, Other  
(Describe)

WELL GROUTED TO A DEPTH OF 0 FEET  
Type Grout (circle one): Cement, Bentonite, or Mix or Mix

SCREEN DATA

Diameter - inches	Length - Feet	Slot Size - inches
<u>4"</u>	<u>10</u>	<u>.012</u>

Screen Type PVC Depth to Bottom - Feet 180'

I certify that the well was drilled, constructed and completed in accordance with all applicable Requirements of the Mississippi Department of Environmental Quality and/or the Mississippi Department of Health regulations and state laws.


Bruce Fitzgerald 029  
Signature of Licensed Driller and License No.

2-27-02  
Date

Additional Information Required On Back

If well telescopes please sketch and show depths.

GROUND LEVEL

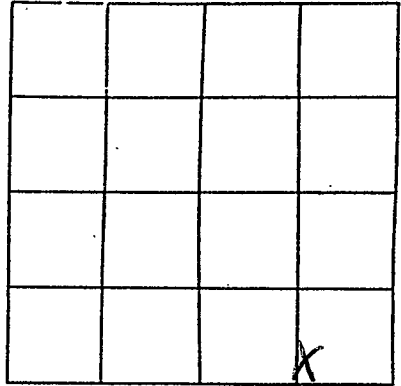

SECTION 14

Please indicate well location X.

Pump Capacity (GPM)	No. of Stages	Setting Depth	
<u>12</u>	<u>8</u>	<u>140</u>	FT.

PUMP TEST

Well yielded \_\_\_\_\_ GPM with  
a drawdown of \_\_\_\_\_ ft.  
after \_\_\_\_\_ hours of pumping

LOG DATA

TYPE OF LOG RUN (Circle One): \_\_\_\_\_ No Log Run,  
Electric, Gamma Ray, Density, Sonic, Neutron,  
Other (Describe) \_\_\_\_\_

Name of Organization Running Log

GEOLOGIC DATA (Office Use Only)

Surface Elev.	Geologic Unit	Unit Thickness	Depth to Top
Subs. SWL	Date	Analysis	Aquifer Test

Driller's Remarks

If more than one screen,  
show location of each on sketch.