

**MISSISSIPPI DEPARTMENT OF ENVIRONMENTAL QUALITY**

Office of Land and Water Resources

P. O. Box 10631  
Jackson, MS 39289-0631  
**WATER WELL DRILLERS LOG**

COUNTY WELL LOCATED <i>Pike</i>	
WELL NUMBER <i>86</i>	CODED
<i>E-2141</i>	
DATE WELL COMPLETED <i>8-21-02</i>	

PERMIT NUMBER <i>057</i>
NAME OF DRILLING FIRM <i>Reeves well ser</i>

NAME & MAILING ADDRESS OF LANDOWNER <i>Homer Salsman 3176 Joel Lang Rd. McComb, MS 39648</i>			
Latitude: Longitude:			
WELL LOCATION	SEC <i>34</i>	TOWNSHIP <i>3</i>	RANGE <i>N 8 W</i>
DISTANCE <i>5</i> Miles	DIRECTION <i>SE</i>	NEAREST TOWN <i>McComb</i>	
OTHER LANDMARK			
WELL PURPOSE: <u>Home</u> , Irrigation, Municipal, Industrial, Fish Pond, etc.			

<b>PUMP DATA</b>			
PUMP TYPE (Circle One): Submersible, Turbine, Jet, Flowing Well, Other (Describe) _____			
POWER TYPE (Circle One): <u>Electric</u> , Tractor, Diesel, Gasoline, <u>1</u> Butane, Other (Describe) _____ H/P <u>2</u>			

DESCRIPTION OF FORMATIONS ENCOUNTERED	FROM	TO
<i>Drift</i>	<i>0</i>	<i>20</i>
<i>Sand &amp; clay</i>	<i>20</i>	<i>60</i>
<i>Red clay</i>	<i>60</i>	<i>90</i>
<i>Sand &amp; Gravel</i>	<i>90</i>	<i>110</i>
<i>Sand &amp; pebbles</i>	<i>110</i>	<i>130</i>

<b>WELL DATA</b>		
Well Depth <i>130'</i>	Casing Diameter (in.) <i>4"</i>	Casing Length (Ft.) <i>20'</i>
Type of Casing <i>pvc</i>	Hole Depth <i>130'</i>	Depth to Static Water Level <i>80'</i>
TYPE OF COMPLETION: (Circle One or More): Gravel Packed, Underreamed, Telescoped, Natural Development, Open Hole, Other (Describe) <u><i>1 @ 90' sand</i></u>		

WELL GROUTED TO A DEPTH OF <u><i>10</i></u> FEET Type Grout (circle one): <u>Cement</u> , Bentonite, or Mix
--

<b>SCREEN DATA</b>		
Diameter - Inches <i>4"</i>	Length - Feet <i>10'</i>	Slot Size - Inches <i>10/5107</i>
Screen Type <i>pvc</i>	Depth to Bottom - Feet <i>130'</i>	

<b>RECEIVED</b>	
<i>OCT 14 2002</i>	
<b>BY: OLWR</b>	
Top of Lap Pipe or Reduction in Casing	FEET <input type="checkbox"/> IF TELESCOPED OR MORE THAN ONE SCREEN: USE BACK PAGE


I certify that the well was drilled, constructed and completed in accordance with all applicable Requirements of the Mississippi Department of Environmental Quality and/or the Mississippi Department of Health regulations and state laws.

*Jimmy Reeves 0668*  
Signature of Licensed Driller and License No.

*8-21-02*  
Date

If well telescopes please sketch and show depths.

GROUND LEVEL

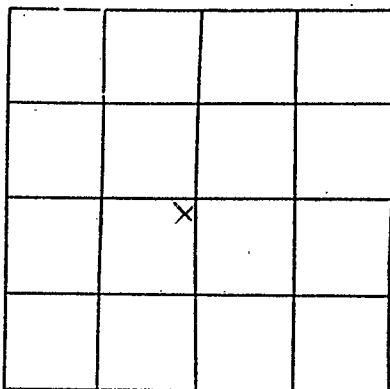

SECTION 34

Please indicate well location X.

Pump Capacity (GPM)	No. of Stages	Setting Depth	
<u>10</u>	<u>8</u>	<u>120'</u>	FT.

PUMP TEST

Well yielded 500 GPM with  
 a drawdown of 0 ft.  
 after 1 hours of pumping

LOG DATA

TYPE OF LOG RUN (Circle One):  No Log Run,  Electric,  Gamma Ray,  Density,  Sonic,  Neutron,  Other (Describe) \_\_\_\_\_

Name of Organization Running Log \_\_\_\_\_

GEOLOGIC DATA (Office Use Only)

Surface Elev.	Geologic Unit	Unit Thickness	Depth to Top
Subs. SWL	Date	Analysis	Aquifer Test

Driller's Remarks

If more than one screen, show location of each on sketch.