

8-23-62 CODED WATER WELL DRILLERS LOG

Date: 8-23, 1962, Driller: Chester Reeves County: Pike  
 (Name)

(1) Owner of Land: Jesse Hux  
 (Name)  
RFD, Tylertown  
 (Address)

(2) Location: 1/4, 1/4, Sec. 35-39 T. 39 R. 9  
13 miles EAST of McComb  
 (distance) (direction) (Nearest Town)

(3) Topography: Flat  
 (Hilly) (Flat) (Level)

(4) Purpose of Well: Domestic  
 (Domestic Irrigation  
 Municipal, Industrial, Other)

Description & Color of Materials Sand, Clay, Red Clay, Shell, etc.	Thick- ness Feet	Depth Feet
<u>Clay</u>	<u>12</u>	<u>12</u>
<u>Sand &amp; gravel</u>	<u>13</u>	<u>25</u>
<u>Blue clay</u>	<u>20</u>	<u>45</u>
<u>fine cherty sand</u>	<u>50</u>	<u>95</u>
<u>Coarse sand</u>	<u>14</u>	<u>109</u>

Information upon completion of well:

(1) Diameter 2' inches.


(2) Total Depth 109 feet.

(3) Water Level 20 feet below top of ground.

(4) Cased to Bottom, Size 2'

(5) Screen: Size 1/4", Length 6'

(6) Were any formations sealed against pollution?  
 \_\_\_\_\_ yes,  no.

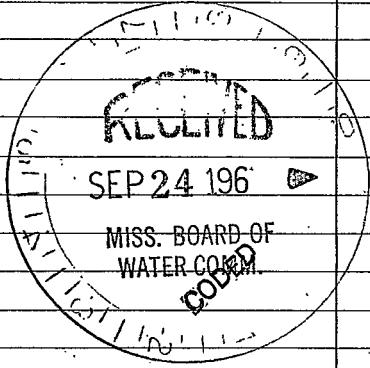

REEVES WELL AND PUMP CO.  
 Phone 1250  
 McCOMB, MISSISSIPPI

If YES depth of formation \_\_\_\_\_

Why \_\_\_\_\_

Drillers Remarks: New house

(Use Back Side)

Well No.

1870

1871

1872

1873

1874

1875