

PIKE
F 6 CODED

MISSISSIPPI BOARD OF WATER COMMISSIONERS

1-28-63

CODED

WATER WELL DRILLERS LOG

Date: 1-28, 1963 Driller: Ed Jones County: Leflore
(Name)


(1) Owner of Land:	Description & Color of Materials Sand, Clay, Red Clay, Shell, etc.	Thick- ness Feet	Depth Feet
<u>Fairly Pittman</u> (Name) <u>Rt. 3 - Box 12.3</u> (Address) <u>Tylertown, Miss</u>	<u>Red Sandy Clay</u>	<u>0</u>	<u>65</u>
(2) Location: <u>SE 1/4, NE 1/4, Sec. 14 T3 R94</u>	<u>Clay</u>	<u>65</u>	<u>75</u>
<u>10</u> miles <u>E</u> of <u>McComb</u> (distance) (direction) (Nearest Town)	<u>Sand + Gravel</u>	<u>75</u>	<u>146</u>
(3) Topography: <u>Hilly</u> (Hilly) (Flat) (Level)			
(4) Purpose of Well: <u>Domestic</u> (Domestic Irrigation Municipal, Industrial, Other)			

Information upon completion of well:

- (1) Diameter 4 1/2 inches.
- (2) Total Depth 146 feet.
- (3) Water Level 97 feet below top of ground.
- (4) Cased to 146', Size 2"
- (5) Screen: Size .08, Length 6'
- (6) Were any formations sealed against pollution?
_____ yes, No no.

If YES depth of formation _____
Why _____

Drillers Remarks: _____

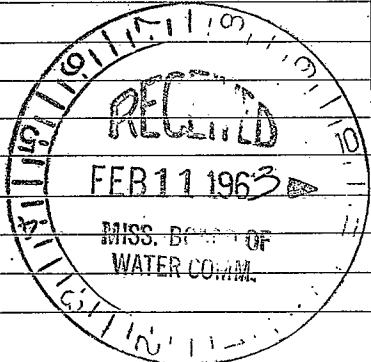

(Use Back Side)

Well No. 25

