

PIKE
F7

WATER WELL DRILLERS LOG **CODED**

Date: 6-10-63, 1963, Driller: Dexter Lewis County Pike
6-10-63 (Name)

(1) Owner of Land: A. E. Andrews
(Name)
M. C. Lamb
(Address) 28 39

(2) Location: 1/4, 1/4, Sec. 28 39
at Calmesville
(distance) (direction) (Nearest Town)

(3) Topography: River Bank
(Hilly) (Flat) (Level)

(4) Purpose of Well: Domestic
(Domestic Irrigation
Municipal, Industrial, Other)

Description & Color of Materials Sand, Clay, Red Clay, Shell, etc.	Thick- ness Feet	Depth Feet
<u>top soil</u>	<u>5</u>	<u>5</u>
<u>chert & sand</u>	<u>24</u>	<u>29</u>
<u>limestone chert</u>	<u>20</u>	<u>49</u>
<u>fine sand</u>	<u>15</u>	<u>64</u>
<u>coarse sand</u>	<u>20</u>	<u>84</u>

Information upon completion of well:

(1) Diameter 4 inches.


(2) Total Depth 90 feet.

(3) Water Level 29 feet below top of ground.

(4) Cased to bottom Size 4

(5) Screen: Size 4", Length 4'

(6) Were any formations sealed against pollution?
yes, no.

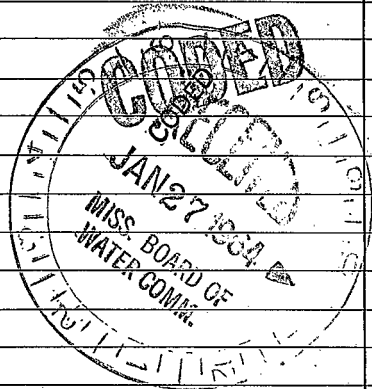

If YES depth of formation _____

Why _____

Drillers Remarks: New House

REEVES WELL & PUMP CO.
P. O. BOX 71 - PHONE 684-451

(Use Back Side)

Well No.

1870

1870

