

PIKE
F8
10-30-63
CODED
CODED

MISSISSIPPI BOARD OF WATER COMMISSIONERS

WATER WELL DRILLERS LOG

CODED

Date: 10-30, 1963, Driller: Chester Reeves County Pike
(Name)


(1) Owner of Land: J. C. Calhoun
(Name)
McComb
(Address)
(2) Location: 1/4, 1/4, Sec. 28 T 39 R 9
at Halmesville
(distance) (direction) (Nearest Town)
(3) Topography: Flat
(Hilly) (Flat) (Level)
(4) Purpose of Well: Domestic
(Domestic Irrigation
Municipal, Industrial, Other)

Description & Color of Materials Sand, Clay, Red Clay, Shell, etc.	Thick- ness Feet	Dep Fe
<u>black sandy loam</u>	<u>11-10</u>	
<u>silt</u>	<u>7-17</u>	
<u>subd gravel</u>	<u>43-60</u>	
<u>white chalk</u>	<u>25-85</u>	
<u>fine white sand</u>	<u>15-100</u>	

Information upon completion of well:

(1) Diameter 2 inches.
(2) Total Depth 100 feet.
(3) Water Level 16 feet below top of ground.
(4) Cased to bottom Size 2
(5) Screen: Size 1 1/4, Length 6'
(6) Were any formations sealed against pollution?
yes, no.

CODED

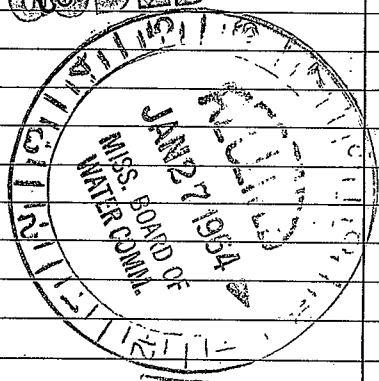

If YES depth of formation _____
Why _____

Drillers Remarks: old well
not adequate

REEVES WELL & PUMP CO.
P. O. BOX 71 - PHONE 684-1451
McCOMB, MISS.

(Use Back Side)

Well No.

