

PIKE

F9

CODED

MISSISSIPPI BOARD OF WATER COMMISSIONERS

8-25-65

CODED

WATER WELL DRILLERS LOG

Date: 8-25, 1965, Driller: J. T. Covington and son County PIKE (Name)

(1) Owner of Land: Bearden
 (Name)
McComb, Miss
 (Address)

(2) Location: 1/4, 1/4, Sec. 6 T3R9
7 miles E/NE of McComb
 (distance) (direction) (Nearest Town)

(3) Topography: Hilly
 (Hilly) (Flat) (Level)

(4) Purpose of Well: Domestic
 (Domestic Irrigation
 Municipal, Industrial, Other)

Description & Color of Materials Sand, Clay, Red Clay, Shell, etc.	Thick- ness Feet	Depth Feet
<u>SANDY CLAY</u>	<u>10</u>	<u>10</u>
<u>SAND + ROCK</u>	<u>34</u>	<u>44</u>

CODED

Information upon completion of well:

(1) Diameter 4" inches.


(2) Total Depth 44 feet.

(3) Water Level 30' feet below top of ground.

(4) Cased to 44', Size 4"

(5) Screen: Size 4", Length 6'

(6) Were any formations sealed against pollution?
 _____ yes, no.

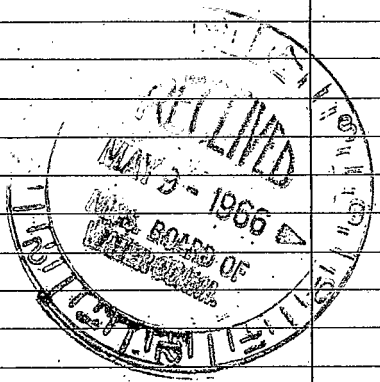

If YES depth of formation _____

Why _____

Drillers Remarks: _____

(Use Back Side)

Well No.

