

**MISSISSIPPI
BOARD OF WATER COMMISSIONERS**
416 North State Street
Jackson, Mississippi 39201

WATER WELL DRILLERS LOG

Pike
792 CODED
6-67

June 29 19*67* at *Keenerwell pumps* *Pike*
date well completed firm name county well located

LANDOWNER: *Leif Seage*
RFD 2
McComb
(mailing address)

description of formations encountered	from	to
<i>Red clay</i>	<i>0</i>	<i>12</i>
<i>Red Sand & Clay</i>	<i>12</i>	<i>45</i>
<i>Red Sand</i>	<i>45</i>	<i>65</i>
<i>chalky gravel</i>	<i>65</i>	<i>90</i>
<i>Red sandy sand</i>	<i>90</i>	<i>112</i>
<i>Small gravel & sand</i>	<i>112</i>	<i>127</i>


WELL LOCATION:
se *32* T *3* N R *9* E
9 miles *SE* of *McComb*
(distance) (direction) (nearest town)

WELL PURPOSE: *Domestic*
(home, irrigation, municipal, industrial)

WELL COMPLETION DATA:


- (1) diameter (inches) *4*
- (2) total depth (feet) *127*
- (3) static water level (feet) *105* below above top of ground
- (4) casing *Plastic Bottom*
(material) (depth)
- _____ if telescope see back, (size)
- (5) screen *6'* *12'*
(length) (depth to top)
4" *Plastic*
(size) (material)
- (6) pump *3/4 Sub* *10*
(HP) (yield gpm)
Elect
(type power)
- (7) electric log *NO*
(yes or no)
(organization running log)
- (8) how well bottom plugged *wooden plug*

DRILLERS REMARKS:
New House

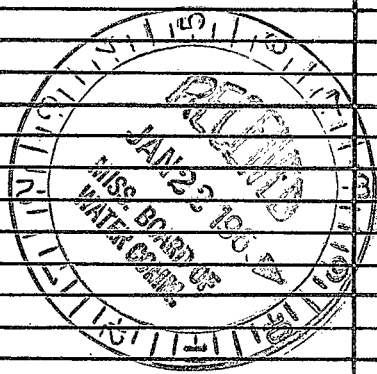

If well telescopes please sketch and show depths.

GROUND LEVEL

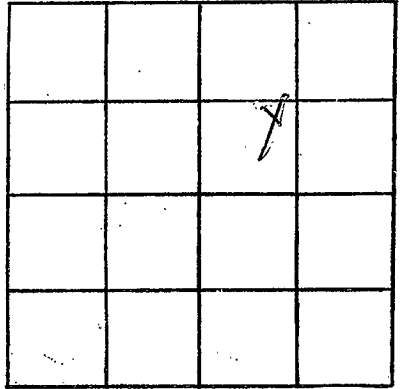

SECTION 32

Please indicate well location X.

ADDITIONAL INFORMATION

If more than one screen, show locations of each on sketch.