

**MISSISSIPPI
BOARD OF WATER COMMISSIONERS**
416 North State Street
Jackson, Mississippi 39201

WATER WELL DRILLERS LOG

~~713~~ **713**
9-67

Sept 14 1967 Revera Well Drilling Co Ribe
date well completed firm name county well located

LANDOWNER: Kath Crawford
PL 3
Plantation
(mailing address)

WELL LOCATION:
sec 35 T 3 N R 9 E
12 miles SE of McComb
(distance) (direction) (nearest town)


WELL PURPOSE: Drainage
(home, irrigation, municipal, industrial)

WELL COMPLETION DATA:

- (1) diameter (inches) 4"
- (2) total depth (feet) 107
- (3) static water level (feet) 25 below top of ground
- (4) casing Plastic Bottom
(material) (depth)
- _____ if telescope see back.
(size)
- (5) screen 6' 101'
(length) (depth to top)
- 1 1/2" Plastic
(size) (material)
- (6) pump 1/2 HP 12
(HP) (yield gpm)
- Elect
(type power)
- (7) electric log NO
(yes or no)
- _____ (organization running log)
- (8) how well bottom plugged wood chips

description of formations encountered	from	to
clay	0	8
sand & gravel	8	35
unyielding sand	35	80
coarse sand	80	107


CODED

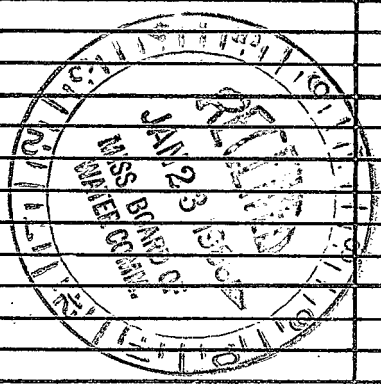

DRILLERS REMARKS:
no existing well

If well telescopes please sketch and show depths.

GROUND LEVEL

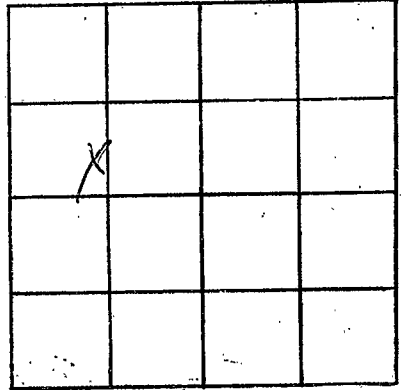

SECTION 35

Please indicate well location X.

ADDITIONAL INFORMATION

If more than one screen, show locations of each on sketch.