

**MISSISSIPPI
BOARD OF WATER COMMISSIONERS**
416 North State Street
Jackson, Mississippi 39201

WATER WELL DRILLERS LOG

Pike
714
10-67

0015 19*67* *Reverwell Pump & Pipe* *Pike*
date well completed firm name county well located

LANDOWNER: *Phyl Enacks -*
McLamb -

description of formations encountered	from	to
<i>sand</i>	<i>0</i>	<i>12</i>
<i>gravel & sand</i>	<i>12</i>	<i>22</i>
<i>chalk & sand</i>	<i>22</i>	<i>50</i>
<i>Red gravel & sand</i>	<i>50</i>	<i>64</i>

(mailing address)

WELL LOCATION:
sec *21* T *3* N R *9* E
1/2 miles *E* *Schmull*
(distance) (direction) (nearest town)


WELL PURPOSE: *Camp*
(home, irrigation, municipal, industrial)

WELL COMPLETION DATA:

- (1) diameter (inches) *4*
- (2) total depth (feet) *64*
- (3) static water level (feet) *22* below top of ground.
- (4) casing *Plastic* *Bottom*
(material) (depth)
- (size) if telescope see back.
- (5) screen *6'* *58'*
(length) (depth to top)
4" *Plastic*
(size) (material)
- (6) pump *used jet* *Electric*
(type power) (yield gpm)
- (7) electric log *NO*
(yes or no)
- (organization running log)

(8) how well bottom plugged *wooden plug*

DRILLERS REMARKS: *old well bob*

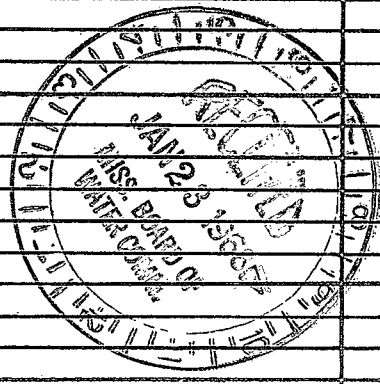

CODED

If well telescopes please sketch and show depths.

GROUND LEVEL

	X		

SECTION 21

Please indicate well location X.

ADDITIONAL INFORMATION

If more than one screen, show locations of each on sketch.