

Pike  
 7-68  
 2-68

MISSISSIPPI  
 BOARD OF WATER COMMISSIONERS  
 416 North State Street  
 Jackson, Mississippi 39201

WATER WELL DRILLERS LOG

Feb 9 1968 Fitzgerald well Inc Pike  
 date well completed firm name county well located

LANDOWNER: Ernest Matthews  
RT 2  
M<sup>c</sup>Comb Miss  
 (mailing address)

description of formations encountered	from	to
Red Clay	0	20
Red sand	20	60
Red gravel	60	76
Solid Rocks - white chalk	76	94
Course sand gravel	94	155
	155	163

WELL LOCATION:  
 sec. 23 T. 3 N. R. 9 E.  
3 miles ENE of Hornersville  
 (distance) (direction) (nearest town)

WELL PURPOSE: Home  
 (home, irrigation, municipal, industrial)

WELL COMPLETION DATA:

(1) diameter (inches) 4"

(2) total depth (feet) 163'

(3) static water level (feet) 110 below top of ground.

(4) casing Plastic 157' (material) (depth)  
4" (size) if telescope see back.

(5) screen 6' (length) 157' (depth to top)  
4" (size) Plastic (material)


(6) pump 1/2 (HP) 12 (yield gpm)  
Electric (type power)

(7) electric log No (yes or no)  
 (organization running log)

(8) how well bottom plugged wood peg


DRILLERS REMARKS:

CODED

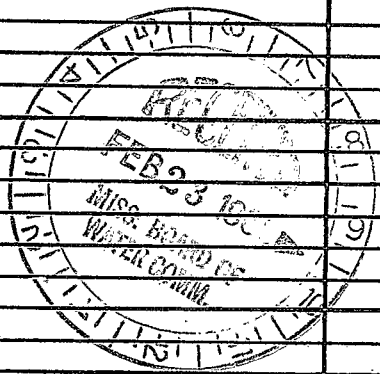

If well telescopes please sketch and show depths.

GROUND LEVEL

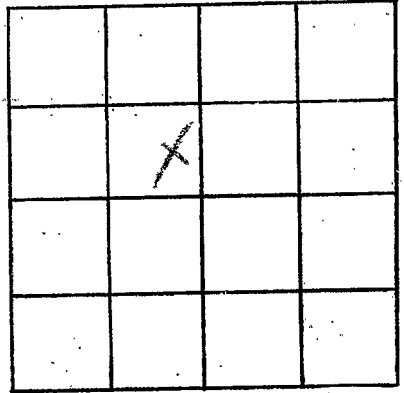

SECTION 23

Please indicate well location X.

ADDITIONAL INFORMATION

If more than one screen,  
show locations of each on sketch.