

PIKE
F18

MISSISSIPPI BOARD OF WATER COMMISSIONERS

11-26-65

WATER WELL DRILLERS LOG

CODED

Date: 11-26, 1965, Driller: Chester Reeves County Pike

(Name)

(1) Owner of Land: J. B. Conerly
(Name)
Rt-2, McCamb
(Address)

(2) Location: 1/4, 1/4, Sec. 30 T3R9,
10 miles East of McCamb
(distance) (direction) (Nearest Town)
on Highway 98

(3) Topography: Hilly
(Hilly) (Flat) (Level)

(4) Purpose of Well: Domestic
(Domestic Irrigation
Municipal, Industrial, Other)

Description & Color of Materials Sand, Clay, Red Clay, Shell, etc.	Thick- ness Feet	Depth Feet
<u>Clay</u>	<u>20</u>	<u>20</u>
<u>bed sand</u>	<u>40</u>	<u>60</u>
<u>big gravel sand</u>	<u>103</u>	<u>103</u>
<u>small pebbles</u>		
<u>sand</u>	<u>37</u>	<u>140</u>

Information upon completion of well:

(1) Diameter 4 inches.

(2) Total Depth 140 feet.

(3) Water Level 110 feet below top of ground.

(4) Cased to bottom, Size 4"


(5) Screen: Size 4", Length 6'

(6) Were any formations sealed against pollution?
no

If YES depth of formation _____
Why _____

Drillers Remarks: new house
no remains well

CODED

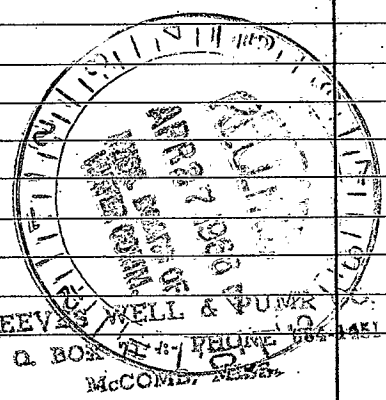

(Use Back Side)

Well No.

...the ... of ...

...the ... of ...

