

PIKE  
F19

MISSISSIPPI BOARD OF WATER COMMISSIONERS

4-23-66

CODED

WATER WELL DRILLERS LOG

Date: 4-23, 1966, Driller: Chester Reeves County Pike  
(When well drilled) (Name) (Where well is located)

(1) Owner of Land: Mrs. W. A. Walker  
 (Name)  
 Rt 2, McCamb.  
 (Address) 25 3 28

(2) Location: 1/4, 1/4, Sec. 29 23 T3 R9  
 (distance) 10 miles East of McCamb.  
 (direction) (Nearest Town)

(3) Topography: Hilly  
 (Hilly) (Flat) (Level)

(4) Purpose of Well: Domestic  
 (Domestic Irrigation  
 Municipal, Industrial, Other)

Description & Color of Materials Sand, Clay, Red Clay, Shell, etc.	Thick- ness Feet	Depth Feet
Top clay gravel	20	20
yellow gravel	40	60
gravel sand		
Brown -	55	115

Information upon completion of well:

(1) Diameter 4 inches.

(2) Total Depth 115 feet.

(3) Water Level 90 feet below top of ground.

(4) Cased to Bottom Size 4"

(5) Screen: Size 4", Length 6'

(6) Were any formations sealed against pollution?  
 yes,  no.

CODED

If YES depth of formation


Why

Drillers Remarks: Red well nests

Yield in gpm: Pumped 15

Size pump: 1/2 HP Sub

Type power: Electric

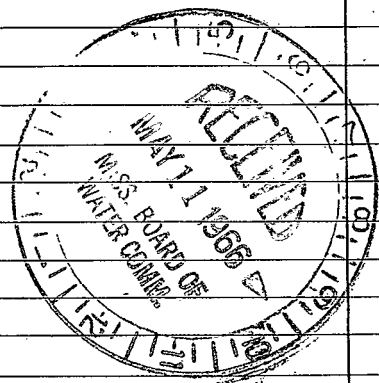

REEVES WELL & PUMP CO.  
 P. O. BOX 71 -- PHONE 884-7451  
 McCOMB, MISS.

