

PIKE
F20

MISSISSIPPI BOARD OF WATER COMMISSIONERS

CODED

7-23-65

WATER WELL DRILLERS LOG

Date: 7-23, 1965, Driller: Chute, Rankin County, Pike

(Name)

(1) Owner of Land: V.W. Barr, Jr.
 Rt. 2, McLamb
(Name)
(Address)

(2) Location: 1/4, 1/4, Sec. 32 39
11 miles East of McLamb
(distance) (direction) (Nearest Town)

(3) Topography: Hilly
(Hilly) (Flat) (Level)

(4) Purpose of Well: Domestic
(Domestic Irrigation)
Municipal, Industrial, Other)

Description & Color of Materials Sand, Clay, Red Clay, Shell, etc.	Thick- ness Feet	Depth Feet
<u>Red Clay</u>	<u>15</u>	<u>15</u>
<u>Sand</u>	<u>45</u>	<u>60</u>
<u>White Shale</u>	<u>15</u>	<u>75</u>
<u>Gravel & Sand</u>	<u>20</u>	<u>101</u>
<u>not coded.</u>		

Information upon completion of well:

(1) Diameter 4 inches.

(2) Total Depth 101 feet.

(3) Water Level 40 feet below top of ground.

(4) Cased to Bottom Size 4"

(5) Screen: Size 4", Length 7'


(6) Were any formations sealed against pollution?
 _____ yes, ✓ no.

cannot locate.
RA

If YES depth of formation _____

Why _____

Drillers Remarks: good well
bad

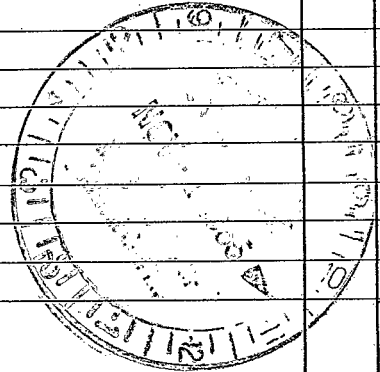

(Use Back Side)

Well No.

