

F21

2-25-63

WATER WELL DRILLERS LOG

Date: 2-25, 1963, Driller: Chester Reeves County: PIKE

(Name)


(1) Owner of Land	Description & Color of Materials Sand, Clay, Red Clay, Shell, etc.	Thick- ness Feet	De Fe
Mrs. W.A. Walker (Name) RFD 2, McComb (Address)	Clay	20	20
(2) Location: 1/4, 1/4, Sec. 32 39 T R 1.2 miles EAST of McComb (distance) (direction) (Nearest Town)	Red sand Chalk	100	120
(3) Topography: Hilly (Hilly) (Flat) (Level)	Coarse white sand	11	131
(4) Purpose of Well: Domestic (Domestic Irrigation, Municipal, Industrial, Other)			

Information upon completion of well:

- (1) Diameter 4" inches.
- (2) Total Depth 131 feet.
- (3) Water Level 3.5 feet below top of ground.
- (4) Cased to bottom size 4"
- (5) Screen: Size 4", Length 4"
- (6) Were any formations sealed against pollution?
yes, no.

Cannot locate

OR

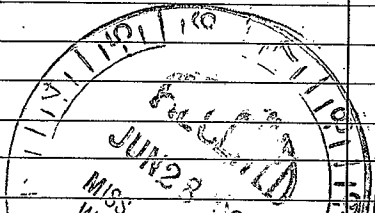

If YES depth of formation

Why

Drillers Remarks: Bad well

REEVES-WELL & PUMP CO. P. O. BOX 71 - PHONE 684-1451 McCOMB, MISS.

(Use Back Side)

Well No.

Handwritten text, likely bleed-through from the reverse side of the page. The text is extremely faint and illegible due to the high contrast of the scan. It appears to be organized into several paragraphs or sections, possibly containing names, dates, and descriptive notes. Some words like "1860" and "1861" are faintly visible, suggesting a chronological record or list.