

Pike  
 F 2400DED  
 1968

MISSISSIPPI  
 BOARD OF WATER COMMISSIONERS  
 416 North State Street  
 Jackson, Mississippi 39201

WATER WELL DRILLERS LOG

May 25 68 Reeves Well Drilling, Pike  
 date well completed firm name county well located

LANDOWNER: Jewell Smith  
 McComb

description of formations encountered	from	to
clay	0	10
fine sand & clay	10	50
coarse sand	50	60

(mailing address)

WELL LOCATION:

sec. 12 T. 3 N. R. 9 E.  
 1/2 miles E of McComb  
 (distance) (direction) (nearest town)

WELL PURPOSE: Camp  
 (home, irrigation, municipal, industrial)

WELL COMPLETION DATA:

- (1) diameter (inches) 4"
- (2) total depth (feet) 60
- (3) static water level (feet) 22 below top of ground.
- (4) casing: Plastic Ballast (material) (depth)

CODED

- (5) screen: 6' length, 50' depth to top, 4" size, Plastic material

- (6) pump: hand pumped (type power)

- (7) electric log: no (yes or no)


- (8) how well bottom plugged: wood chip

DRILLERS REMARKS: Camp site

APR 17 1968  
 MISS. BOARD OF  
 WATER COM. 1

If well telescopes please sketch and show depths.

GROUND LEVEL

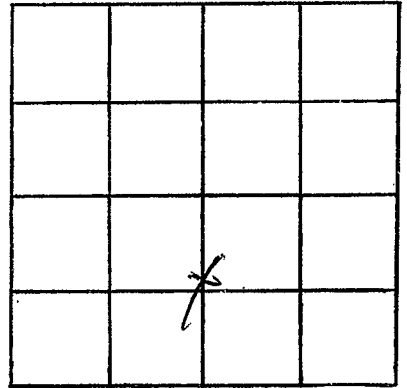

SECTION 17

Please indicate well location X.

ADDITIONAL INFORMATION

If more than one screen,  
show locations of each on sketch.