

Pike CODED
726
9-24-68

MISSISSIPPI
 BOARD OF WATER COMMISSIONERS
 416 North State Street
 Jackson, Mississippi 39201

CODE

WATER WELL DRILLERS LOG

9-24 1968 Fitzgerald well serv Pike
 date well completed firm name county well located

LANDOWNER:

Eel Holmes
R.R. McComb Miss.
 (mailing address)

description of fomations encountered

	from	to
<u>Red Clay</u>	<u>0</u>	<u>20</u>
<u>Coarse Sand & gravel</u>	<u>20</u>	<u>60</u>
<u>Fine Sand</u>	<u>60</u>	<u>90</u>
<u>Coarse Sand & gravel</u>	<u>90</u>	<u>100</u>

WELL LOCATION:


sec. 21 T. 3 N. R. 9 E.
8 miles E of McComb
 (distance) (direction) (nearest town)

WELL PURPOSE: Home
 (home, irrigation, municipal, industrial)

WELL COMPLETION DATA:


- (1) diameter (inches) 4
- (2) total depth (feet) 100
- (3) static water level (feet) 35 below above top of ground.
- (4) casing Plastic 94
 (material) (depth)
4 if telescope see back.
 (size)
- (5) screen 6' 94
 (length) (depth to top)
4 Plastic
 (size) (material)
- (6) pump ? ?
 (HP) (yield gpm)
Electric
 (type power)
- (7) electric log no
 (yes or no)
(organization running log)
- (8) how well bottom plugged coiled pipe

DRILLERS REMARKS:

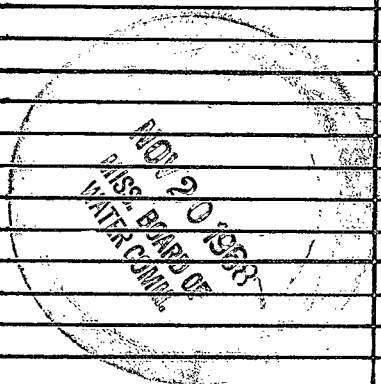

If well telescopes please sketch and show depths.

GROUND LEVEL

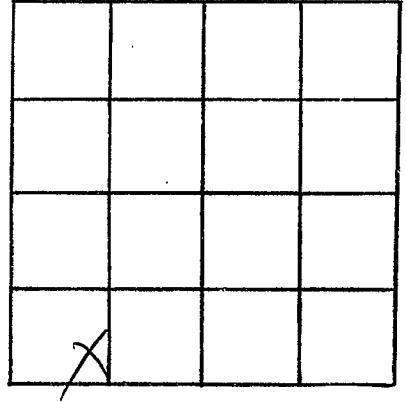

SECTION 21

Please indicate well location X.

ADDITIONAL INFORMATION

If more than one screen, show locations of each on sketch.