

Coded

Pike
F27
8-68

MISSISSIPPI
 BOARD OF WATER COMMISSIONERS
 416 North State Street
 Jackson, Mississippi 39201

WATER WELL DRILLERS LOG

Aug 2 1968 Reeswell Pump Co. Pike
 date well completed firm name county well located

LANDOWNER: W. Cannon
Baptist Church
H-3. Tylerman
 (mailing address)

description of formations encountered	from	to
<u>red clay & gravel</u>	<u>0</u>	<u>12</u>
<u>red stone & chert</u>	<u>12</u>	<u>58</u>
<u>small gravel & sand</u>	<u>58</u>	<u>65</u>
<u>white chert</u>	<u>65</u>	<u>92</u>
<u>fine sand</u>	<u>92</u>	<u>115</u>
<u>coarse sand & gravel</u>	<u>115</u>	<u>133</u>

WELL LOCATION:
 sec 14 T 3 N R 9 E
4 miles 5 Princeton
 (distance) (direction) (nearest town)

WELL PURPOSE: church
 (home, irrigation, municipal, industrial)

WELL COMPLETION DATA:
 (1) diameter (inches) 4"
 (2) total depth (feet) 133
 (3) static water level (feet) 88 below/above top of ground.
 (4) casing plastic ballast
 (material) (depth)

(size) if telescope see back.
 (5) screen 6' 127
4" (length) (depth to top)
plastic
 (size) (material)


(6) pump 1/2 sub-12
select
 (HR) (yield gpm)
 (type power)

(7) electric log no
 (yes or no)

(organization running log)

(8) how well bottom plugged
wooden plug

DRILLERS REMARKS:
old rod pump
bad

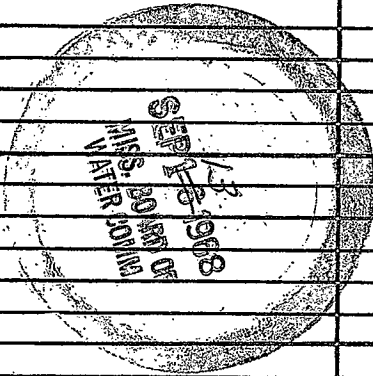

If well telescopes please sketch and show depths.

GROUND LEVEL

	X		

SECTION 14

Please indicate well location X.

ADDITIONAL INFORMATION

If more than one screen, show locations of each on sketch.