

Duke
728
3-27-69

MISSISSIPPI
 BOARD OF WATER COMMISSIONERS
 416 North State Street
 Jackson, Mississippi 39201

CODED

CODED

WATER WELL DRILLERS LOG

3-27 1969 Fitzgerald well firm name Richie county well located

LANDOWNER:
J. D. Leonard
RR. McComb, Miss.
 (mailing address)

description of formations encountered	from	to
Red clay	0	20
Red sand	20	90
Red gravel	90	100
white clay	100	130
Fine sand	130	150
Coarse sand	150	160

WELL LOCATION:
 sec. 23 T. 3 N. R. 9 E.
 S W
1.2 miles E of McComb
 (distance) (direction) (nearest town)

WELL PURPOSE: Home
 (home, irrigation, municipal, industrial)

- WELL COMPLETION DATA:**
- (1) diameter (inches) 4
 - (2) total depth (feet) 160
 - (3) static water level (feet) 105 below/above top of ground.
 - (4) casing Plastic 154
 (material) (depth)
 - 4 If telescope see back.
 (size)
 - (5) screen 6 154
 (length) (depth to top)
 - 4 Plastic
 (size) (material)
 - (6) pump 1/2 10
 (HP) (yield gpm)
 - Clu
 (type power)
 - (7) electric log no
 (yes or no)
 - (organization running log)
 - (8) how well bottom plugged analy


DRILLERS REMARKS:

APP. 20

MISS. B.D. 11
MISS. B.D. 11

If well telescopes please sketch and show depths.

GROUND LEVEL

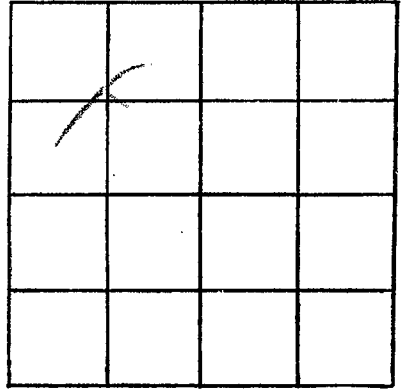

SECTION 

Please indicate well location X.

ADDITIONAL INFORMATION

If more than one screen, show locations of each on sketch.