

CODE 12

MISSISSIPPI
BOARD OF WATER COMMISSIONERS
416 North State Street
Jackson, Mississippi 39201

CODE 1

WATER WELL DRILLERS LOG

Pike
729
3-28-69

3-28 1969 date well completed
Fitzgerald well firm name
Pike county well located

LANDOWNER:
Jimmie Tucker
R.R. McComb Miss.
(mailing address)

description of formations encountered	from	to
Red clay	0	10
Sand & gravel	10	30
Fine sand	30	60
Coarse sand	60	74

WELL LOCATION:
sec. 20 T 3 N R 9 E
S W
8 miles E of McComb
(distance) (direction) (nearest town)

WELL PURPOSE: Home
(home, irrigation, municipal, industrial)

- WELL COMPLETION DATA:
- (1) diameter (inches) 4
 - (2) total depth (feet) 74
 - (3) static water level (feet) 15 below top of ground.
 - (4) casing Plastic 68, (material) (depth)
4 (size) If telescope see back.
 - (5) screen 6 68 (length) (depth to top)
4 (size) Plastic (material)
 - (6) pump 1/2 12 (HP) (yield gpm)
Elu (type power)
 - (7) electric log No (yes or no)
(organization running log)
 - (8) how well bottom plugged gravel


DRILLERS REMARKS:

APR 30

MISSISSIPPI
BOARD OF WATER COMMISSIONERS
JACKSON, MISSISSIPPI

If well telescopes please sketch and show depths.

GROUND LEVEL

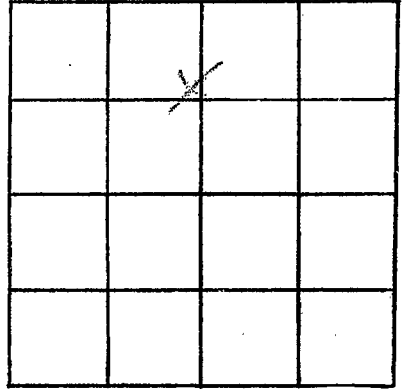

SECTION 20

Please indicate well location X.

ADDITIONAL INFORMATION

If more than one screen, show locations of each on sketch.