

PIKE  
F31  
8-21-70

MISSISSIPPI  
BOARD OF WATER COMMISSIONERS  
416 North State Street  
Jackson, Mississippi 39201

**CODED**

WATER WELL DRILLERS LOG

8-21 1970 F. J. Fitzgerald Pike  
date well completed firm name county well located

LANDOWNER:  
J. J. TUCKER  
Route 2, McComb Miss  
(mailing address)

description of formations encountered	from	to
<u>Red Clay</u>	<u>0</u>	<u>20</u>
<u>Red Sand</u>	<u>20</u>	<u>140</u>
<u>Coarse sand &amp; gravel</u>	<u>140</u>	<u>151</u>

WELL LOCATION:  
sec 20 T 3 N R 9 E  
8 miles E of McComb  
(distance) (direction) (nearest town)

WELL PURPOSE: Home  
(home, irrigation, municipal, industrial)

- WELL COMPLETION DATA:
- (1) diameter (inches) 4
  - (2) total depth (feet) 151
  - (3) static water level (feet) 65 below top of ground
  - (4) casing Plastic 143  
(material) (depth)
  - 4 if telescope see back.  
(size)
  - (5) screen 8 143  
(length) (depth to top)
  - 4 Plastic  
(size) (material)
  - (6) pump 1/2 12  
(HP) (yield gpm)
  - elm  
(type power)
  - (7) electric log no  
(yes or no)
  - (organization running log)
  - (8) how well bottom plugged Good

**CODED**


SEP 14 1970

DRILLERS REMARKS:

MISS. Bd. of  
WATER COMMISSIONERS

If well telescopes please sketch and show depths.

GROUND LEVEL

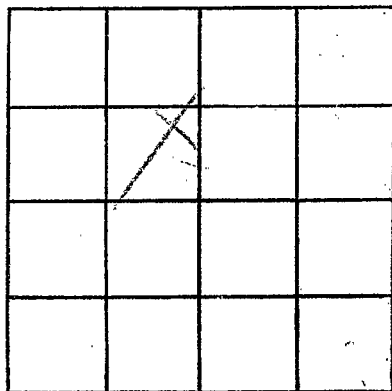

SECTION 20

Please indicate well location X.

ADDITIONAL INFORMATION

If more than one screen,  
show locations of each on sketch.