

MISSISSIPPI
BOARD OF WATER COMMISSIONERS
416 North State Street
Jackson, Mississippi 39201

CODED

WATER WELL DRILLERS LOG

PIKE
F32
8-10-70

Aug 10 1970
date well completed

Chester Keene
firm name

Pike
county well located

LANDOWNER:

Eric Pettman
Rt-1, Summit
(mailing address)

description of formations encountered

from to

Red Clay	0	15
Red Sand	15	80
Gravel	80	100
Sand-gravel-chalk	100	140
Sand & shaly sand	140	159

WELL LOCATION:

sec. 5 T 3 N R 9 E
\$ miles E of Mt. Lamb
(distance) (direction) (nearest town)

WELL PURPOSE:

Home
(home, irrigation, municipal, industrial)

WELL COMPLETION DATA:

- (1) diameter (inches) 4"
- (2) total depth (feet) 159
- (3) static water level (feet) 129 below top of ground.
- (4) casing Plastic bottom
(material) (depth)
- (size) If telescope see back.
- (5) screen 6' 153
(length) (depth to top)
1 1/2" Plastic
(size) (material)
- (6) pump 3/4 HP 12
(HP) (yield gpm)
Electric
(type power)
- (7) electric log NO
(yes or no)

CODED

(organization running log)

(8) how well bottom plugged
wood plug

DRILLERS REMARKS:


New house

SEP 21 1970

MISS. BD. OF
WATER COMM.

If well telescopes please sketch and show depths.

GROUND LEVEL

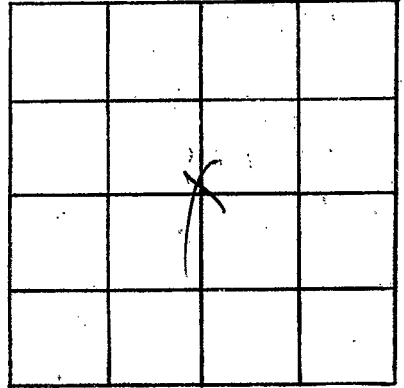

SECTION 5

Please indicate well location X.

ADDITIONAL INFORMATION

If more than one screen,
show locations of each on sketch.