

Pike  
F33  
6-5-70

MISSISSIPPI  
BOARD OF WATER COMMISSIONERS  
416 North State Street  
Jackson, Mississippi 39201

**CODED**

WATER WELL DRILLERS LOG

6-5 date well completed      1970 *Fitzgerald well drill* firm name      *Pike* county well located

LANDOWNER:  
*Roosevelt Quinn*  
*R.R. Johnson*  
(mailing address)

description of formations encountered	from	to
<i>Red clay</i>	0	20
<i>Red sand</i>	20	90
<i>Red gravel</i>	90	115
<i>Red sand</i>	115	146
<i>loose gravel</i>	146	154

WELL LOCATION:  
sec. 11 T. 3 N. R. 9 E  
4 miles SE of Prichard  
(distance) (direction) (nearest town)

WELL PURPOSE: flow  
(home, irrigation, municipal, industrial)

- WELL COMPLETION DATA:
- (1) diameter (inches) 4
  - (2) total depth (feet) 154
  - (3) static water level (feet) 120 below top of ground.
  - (4) casing Plastic 146  
(material) (depth)  
4 If telescope see back.  
(size)
  - (5) screen 8 146  
(length) (depth to top)  
4 Plastic  
(size) (material)
  - (6) pump 1/2 8  
(HP) (yield gpm)  
Electric  
(type power)
  - (7) electric log no  
(yes or no)
  - (8) how well bottom plugged used for

**CODED**


DRILLERS REMARKS:

JUN 29 1970

MISS. BD. OF  
WATER COMMISSIONERS

If well telescopes please sketch and show depths.

GROUND LEVEL

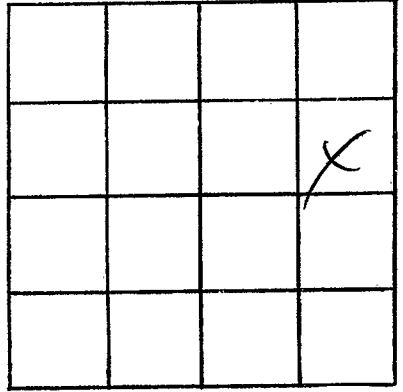

SECTION 11

Please indicate well location X.

ADDITIONAL INFORMATION

If more than one screen, show locations of each on sketch.