

Pike
F34
6-9-70

MISSISSIPPI
BOARD OF WATER COMMISSIONERS
416 North State Street
Jackson, Mississippi 39201

CODED

WATER WELL DRILLERS LOG

June 9 1970 date well completed
Chester Kerner firm name
Pike county well located

LANDOWNER: Robert L. Steverson
RT-2, M. Lamb (mailing address)

WELL LOCATION:
sec. 31 T. 30 N. R. 9 E
0.6 miles (distance) E (direction) of Frumond (nearest town)

WELL PURPOSE: Farm (home, irrigation, municipal, industrial)

- WELL COMPLETION DATA:
- (1) diameter (inches) 4"
 - (2) total depth (feet) 131
 - (3) static water level (feet) 31 below top of ground.
 - (4) casing Plastic Ballam (material) (depth)
 - (5) screen 4" (length) 125 (depth to top) Plastic (material)
 - (6) pump 1/2 HP Elect (type power) 8 (yield gpm)
 - (7) electric log No (yes or no)
 - (8) how well bottom plugged wooden plug

DRILLERS REMARKS:
New house


description of formations encountered	from	to
Red clay	0	4
Red sand	4	40
Sand & gravel	40	60
Chalk	60	102
Coarse sand & red gravel	102	131

CODED

JUL 27 1970

If well telescopes please sketch and show depths.

GROUND LEVEL

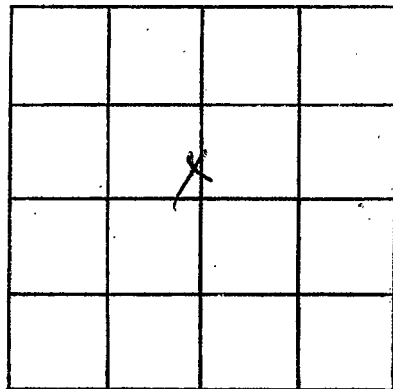

SECTION 31

Please indicate well location X.

ADDITIONAL INFORMATION

If more than one screen,
show locations of each on sketch.