

PIKE  
F 35  
8-20-70

MISSISSIPPI  
BOARD OF WATER COMMISSIONERS  
416 North State Street  
Jackson, Mississippi 39201

**CODED**


WATER WELL DRILLERS LOG

August 20 1970 J.T. Coover + Son PIKE  
date well completed firm name county well located

| LANDOWNER:   | description of formations encountered | from | to |
|--|---------------------------------------|------|----|
| Buck Stodham<br>McComb, Miss<br>(mailing address)  |                                       |      |    |
| WELL LOCATION:   | <b>CODED</b>                          |      |    |
| sec. 29 T. 3 N R. 9 E<br>6 miles East of McComb<br>(distance) (direction) (nearest town) |                                       |      |    |
| WELL PURPOSE: Home<br>(home, irrigation, municipal, industrial)                          |                                       |      |    |
| WELL COMPLETION DATA:  |                                       |      |    |
| (1) diameter (inches) 4"   |                                       |      |    |
| (2) total depth (feet) 115'  |                                       |      |    |
| (3) static water level (feet) 80 below above<br>top of ground                            |                                       |      |    |
| (4) casing Pl 109<br>(material) (depth)<br>(size) if telescope see back.                 |                                       |      |    |
| (5) screen 6' 109<br>(length) (depth to top)<br>4" Pl<br>(size) (material)               |                                       |      |    |
| (6) pump 3/4 8<br>(HP) (yield gpm)<br>Elect<br>(type power)                              |                                       |      |    |
| (7) electric log No<br>(yes or no)   |                                       |      |    |
| (organization running log)   | OCT 13 1970                           |      |    |
| (8) how well bottom plugged Wood   | MISS. BD. OF<br>WATER COM. S.         |      |    |
| DRILLERS REMARKS:  |                                       |      |    |

If well telescopes please sketch and show depths.

GROUND LEVEL

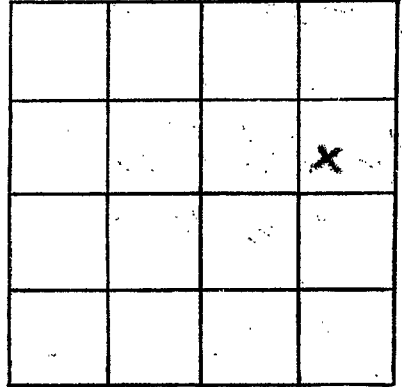

SECTION 29

Please indicate well location X.

ADDITIONAL INFORMATION

If more than one screen, show locations of each on sketch.