

MISSISSIPPI
BOARD OF WATER COMMISSIONERS
416 North State Street
Jackson, Mississippi 39201

CODED

WATER WELL DRILLERS LOG

PIKE
F 36
10-5-70

5 Oct 1970 date well completed
AT. Crawford firm name
Pike county well located

LANDOWNER:
Carl Seng
M^cComb.
(mailing address)

description of formations encountered	from	to
Clay	0	15
Clay shale	15	45
Red shale	45	75
Red Bank	75	126

WELL LOCATION:
sec. 30 T 3 N R 9 E
5 miles East M^cComb.
(distance) (direction) (nearest town)

WELL PURPOSE:
(home, irrigation, municipal, industrial)

- WELL COMPLETION DATA:
- (1) diameter (inches) 4
 - (2) total depth (feet) 126
 - (3) static water level (feet) 90 below top of ground.
 - (4) casing 11 (material), 120 (depth)
 - if telescope see back.
 - (5) screen 6' (length), 120 (depth to top)
 - 4 (size), 11 (material)
 - (6) pump 10 (HP), 10 (yield gpm)
 - Elect. (type power)
 - (7) electric log (yes or no)
 - (organization running log)
 - (8) how well bottom plugged wood

CODED


DEC 16 1970

DRILLERS REMARKS:

MISS. BD. OF
WATER COMMISSIONERS

If well telescopes please sketch and show depths.

GROUND LEVEL

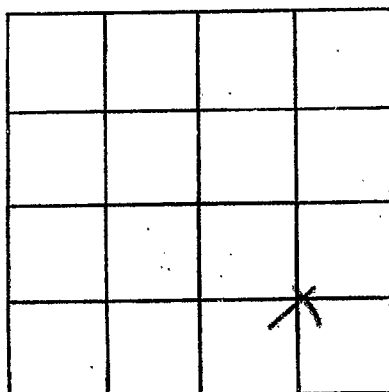

SECTION 30

Please indicate well location X.

ADDITIONAL INFORMATION

If more than one screen, show locations of each on sketch.