

PIKE
 R39
 S-29-69

MISSISSIPPI
 BOARD OF WATER COMMISSIONERS
 416 North State Street
 Jackson, Mississippi 39201

CODED

WATER WELL DRILLERS LOG

May 29 1969 Lewis and Clark Pike
 date well completed firm name county well located

LANDOWNER: DeLoe
 Baker
 RFD - Kentown
 (mailing address)

description of formations encountered	from	to
clay gravel	0	27
Red Sand	27	41
Gravel	41	56
fine Red Sand	56	112
Coarse Sand	112	118

WELL LOCATION:
 sec. 14 T. 3 N R. 9 E
 4 miles S of Pike
 (distance) (direction) (nearest town)

WELL PURPOSE:
 (home, irrigation, municipal, industrial)

WELL COMPLETION DATA:

- (1) diameter (inches) 4"
- (2) total depth (feet) 118
- (3) static water level (feet) 96 below top of ground.
- (4) casing Plastic bottom
 (material) (depth)
- (size) if telescope see back.
- (5) screen 6' 112
 (length) (depth to top)
4" Plastic
 (size) (material)
- (6) pump 1/2 Sub 1 1/2
 (HP) (yield gpm)
elect
 (type power)
- (7) electric log no
 (yes or no)

(organization running log)

(8) how well bottom exposed
bottom

DRILLERS REMARKS:
old well


CODED

AUG 15 1969

MISS. BLD. OF WATER CONTROL

If well telescopes please sketch and show depths.

GROUND LEVEL

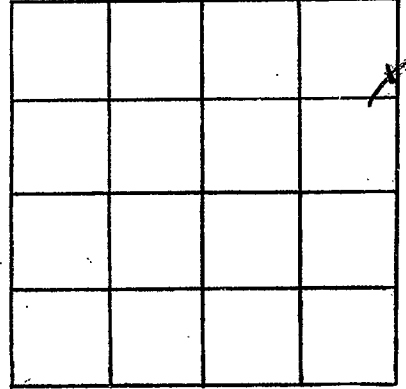

SECTION 14

Please indicate well location X.

ADDITIONAL INFORMATION

If more than one screen,
show locations of each on sketch.