

PIKE
 F 40
 9-2-69

MISSISSIPPI
 BOARD OF WATER COMMISSIONERS
 416 North State Street
 Jackson, Mississippi 39201

CODED

WATER WELL DRILLERS LOG

Sep 2 1969 date well completed
 G. B. Russell & Sons firm name
 Pike county well located

LANDOWNER: Cham
Stevenson
Rt-2, W. C. Lamb
 (mailing address)

WELL LOCATION:
 sec 31 T 3 N R 9 E
7 1/2 miles SE W. C. Lamb
 (distance) (direction) (nearest town)

WELL PURPOSE: Drain
 (home, irrigation, municipal, industrial)

- WELL COMPLETION DATA:
- (1) diameter (inches) 4"
 - (2) total depth (feet) 130
 - (3) static water level (feet) 28 below top of ground.
 - (4) casing Plastic Bottom
 (material) (depth)
 - (5) screen 6' 124'
 (length) (depth to top)
4" Plastic
 (size) (material)
 - (6) pump used old pump
 (HP) (yield gpm)
Elect-
 (type power)
 - (7) electric log NO
 (yes or no)
- (organization running log)
- (8) how well bottom plugged no plug

| description of formations encountered | from | to |
|---------------------------------------|------|-----|
| Red clay gravel | 0 | 18 |
| Red sand | 18 | 50 |
| Chalk & gravel | 50 | 57 |
| white chalk | 57 | 81 |
| fine sandy sand | 81 | 118 |
| Coarse sand | 118 | 130 |

CODED


DRILLERS REMARKS:
No full logs well

SEP 25 1969

MISS. BD. OF
 WATER COMMISSIONERS

If well telescopes please sketch and show depths.

GROUND LEVEL

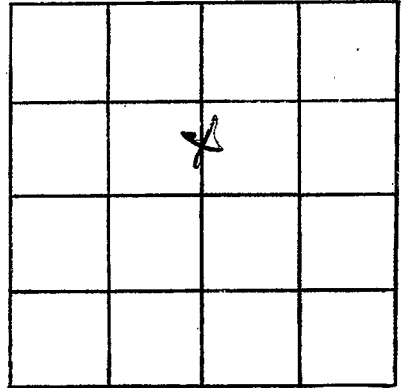

SECTION 31

Please indicate well location X.

ADDITIONAL INFORMATION

If more than one screen,
show locations of each on sketch.