

DIKE
F41
11-18-69

MISSISSIPPI
BOARD OF WATER COMMISSIONERS
416 North State Street
Jackson, Mississippi 39201

CODED

WATER WELL DRILLERS LOG

11-18 1969 Fitzgerald Well Inc. Dike
date well completed firm name county well located

LANDOWNER:
Louis Jones
R.R. 2, McComb Miss.
(mailing address)

description of formations encountered	from	to
<u>Red clay</u>	<u>0</u>	<u>20</u>
<u>Red sand</u>	<u>20</u>	<u>40</u>
<u>Red gravel</u>	<u>40</u>	<u>90</u>
<u>Red sand</u>	<u>90</u>	<u>110</u>
<u>Coarse sand</u>	<u>110</u>	<u>116</u>

WELL LOCATION:
sec. 19 T 3 N R 9 E
S W
6 miles E of McComb
(distance) (direction) (nearest town)

WELL PURPOSE: Home
(home, irrigation, municipal, industrial)

- WELL COMPLETION DATA:
- (1) diameter (inches) 4
 - (2) total depth (feet) 116
 - (3) static water level (feet) 90 below above top of ground.
 - (4) casing plastic, 110 below above top of ground.
(material) (depth)
4 if telescope see back.
(size)
 - (5) screen 6, 110
(length) (depth to top)
4, plastic
(size) (material)
 - (6) pump 1, 7
(HP) (yield gpm)
Electric
(type power)
 - (7) electric log no
(yes or no)
(organization running log)
 - (8) how well bottom plugged as per spec

CODED


DEC 22 1969

MISS. BD. OF
WATER COMMISSIONERS

DRILLERS REMARKS:

If well telescopes please sketch and show depths.

GROUND LEVEL

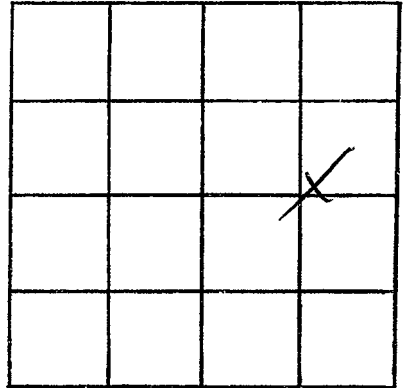

SECTION 19

Please indicate well location X.

ADDITIONAL INFORMATION

If more than one screen,
show locations of each on sketch.