

PIKE
F42
12-1-69

MISSISSIPPI
BOARD OF WATER COMMISSIONERS
416 North State Street
Jackson, Mississippi 39201

CODED

WATER WELL DRILLERS LOG

12-1 1969 Fitzgerald Well Drilling Pike
date well completed firm name county well located

LANDOWNER:
Wallace Mather
P.R. 2 McComb, Miss.
(mailing address)

| description of formations encountered | from | to |
|---------------------------------------|-----------|------------|
| <u>Red clay</u> | <u>0</u> | <u>15</u> |
| <u>Red gravel</u> | <u>15</u> | <u>95</u> |
| <u>Coarse gravel</u> | <u>95</u> | <u>114</u> |

WELL LOCATION:
sec. 32 T 3 N R 9 E
S W
10 miles E of McComb
(distance) (direction) (nearest town)

WELL PURPOSE: Home
(home, irrigation, municipal, industrial)

- WELL COMPLETION DATA:
- (1) diameter (inches) 4
 - (2) total depth (feet) 114
 - (3) static water level (feet) 104 below above top of ground.
 - (4) casing galv. 108,
(material) (depth)
4 if telescope see back.
(size)
 - (5) screen 6 108
(length) (depth to top)
4 galv.
(size) (material)
 - (6) pump 1/2 10
(HP) (yield gpm)
elec.
(type power)
 - (7) electric log no
(yes or no)
(organization running log)
 - (8) how well bottom plugged wood plug


CODED

DRILLERS REMARKS:

DEC 22 1969

If well telescopes please sketch and show depths.

GROUND LEVEL

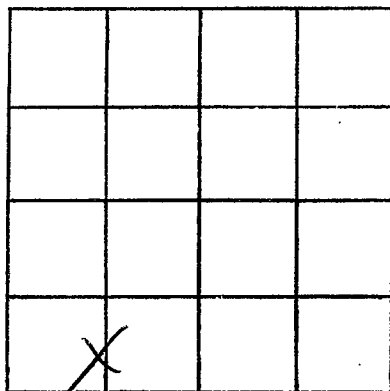

SECTION 32

Please indicate well location X.

ADDITIONAL INFORMATION

If more than one screen,
show locations of each on sketch.