

Pike
743
10-9-69

MISSISSIPPI
 BOARD OF WATER COMMISSIONERS
 416 North State Street
 Jackson, Mississippi 39201

CODED

WATER WELL DRILLERS LOG

Oct 9 1969 Reverwell Drillers Pike
 date well completed firm name county well located

LANDOWNER:	description of formations encountered	from	to
(mailing address)			
WELL LOCATION: sec. <u>11</u> T. <u>3</u> N. R. <u>9</u> E. <u>4</u> miles <u>SSE</u> of <u>Prentiss</u> (distance) (direction) (nearest town)	<u>Red clay</u>	<u>0</u>	<u>19</u>
WELL PURPOSE: <u>Home</u> (home, irrigation, municipal, industrial)	<u>Sand & gravel</u>	<u>19</u>	<u>36</u>
WELL COMPLETION DATA: (1) diameter (inches) <u>4"</u>	<u>white & black chalk</u>	<u>36</u>	<u>132</u>
(2) total depth (feet) <u>165</u>	<u>fine sand</u>	<u>132</u>	<u>157</u>
(3) static water level (feet) <u>7.5</u> below top of ground.	<u>Coarse sand & gravel</u>	<u>157</u>	<u>165</u>
(4) casing <u>Plastic Bottom</u> (material) (depth)			
(5) screen <u>6'</u> <u>159</u> (length) (depth to top)			
(6) pump <u>1/2 Sub 12</u> (HP) (yield gpm)			
(7) electric log <u>NR.</u> (yes or no)			
(8) how well bottom plugged <u>Plug.</u>			
DRILLERS REMARKS:			


CODED

DEC 31 1969

MISS. BD. OF
 WATER

If well telescopes please sketch and show depths.

GROUND LEVEL

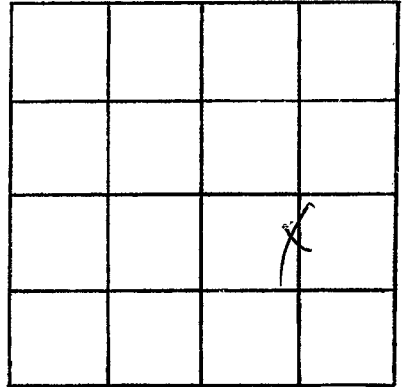

SECTION 11

Please indicate well location X.

ADDITIONAL INFORMATION

If more than one screen,
show locations of each on sketch.