

PIKE
E 44
12-29-69

MISSISSIPPI
 BOARD OF WATER COMMISSIONERS
 416 North State Street
 Jackson, Mississippi 39201

CODED

WATER WELL DRILLERS LOG

12-29 1969 Floyd well Dr Pike
 date well completed firm name county well located

LANDOWNER:
Emmitt Jewell
R.R. McComb, Miss
 (mailing address)

WELL LOCATION:
 sec 4 T 3 N R 9 E
 S W
9 miles E of McComb
 (distance) (direction) (nearest town)

WELL PURPOSE: home
 (home, irrigation, municipal, industrial)

WELL COMPLETION DATA:
 (1) diameter (inches) 4
 (2) total depth (feet) 167
 (3) static water level (feet) 110 below above top of ground.
 (4) casing plastic, 159,
 (material) (depth)
4 if telescope see back.
 (size)
 (5) screen 8, 159
 (length) (depth to top)
4, plastic
 (size) (material)
 (6) pump 1/2 10
 (HP) (yield gpm)
elec
 (type power)
 (7) electric log no
 (yes or no)
 (organization running log)
 (8) how well bottom plugged wood plug

description of formations encountered	from	to
<u>Red clay</u>	<u>0</u>	<u>15</u>
<u>Red sand</u>	<u>15</u>	<u>90</u>
<u>Red gravel</u>	<u>90</u>	<u>120</u>
<u>Red sand</u>	<u>120</u>	<u>150</u>
<u>Coarse sand & gravel</u>	<u>150</u>	<u>167</u>

CODED


JAN 20 1970

MISS. BD. OF
 WATER COMMISSIONERS

DRILLERS REMARKS:

If well telescopes please sketch and show depths.

GROUND LEVEL

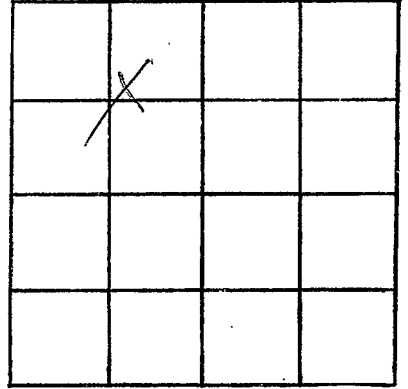

SECTION 4

Please indicate well location X.

ADDITIONAL INFORMATION

If more than one screen,
show locations of each on sketch.