

MISSISSIPPI  
BOARD OF WATER COMMISSIONERS  
416 North State Street  
Jackson, Mississippi 39201

**CODED**

WATER WELL DRILLERS LOG

PIKE  
F 45  
2-12-71

2-12 1971 Fitzgerald well dr Pike  
date well completed firm name county well located

LANDOWNER:  
Fairly Pittman  
RR. Tylentown Min.  
(mailing address)

WELL LOCATION:  
sec. 11 T 30 N R 9 E  
3 miles S of Princeton  
(distance) (direction) (nearest town)

WELL PURPOSE: Home  
(home, irrigation, municipal, industrial)

WELL COMPLETION DATA:

(1) diameter (inches) 2 1/2

(2) total depth (feet) 160

(3) static water level (feet) 105 below above top of ground.

(4) casing Plastic, 154,  
(material) (depth)

4 If telescope see back.  
(size)

(5) screen 6, 154  
(length) (depth to top)

4, Plastic  
(size) (material)

(6) pump 1 3  
(HP) (yield gpm)

Electric  
(type power)

(7) electric log No  
(yes or no)

(organization running log)

(8) how well bottom plugged Unplugged

description of formations encountered	from	to
<u>Red clay</u>	<u>0</u>	<u>20</u>
<u>Red sand</u>	<u>20</u>	<u>95</u>
<u>Red chert</u>	<u>95</u>	<u>115</u>
<u>Red sand</u>	<u>115</u>	<u>150</u>
<u>Coarse sand &amp; gravel</u>	<u>150</u>	<u>160</u>

**CODED**


MAR 5 - 1971

MISS. BD. OF  
WATER COMMISSIONERS

DRILLERS REMARKS:

If well telescopes please sketch and show depths.

GROUND LEVEL

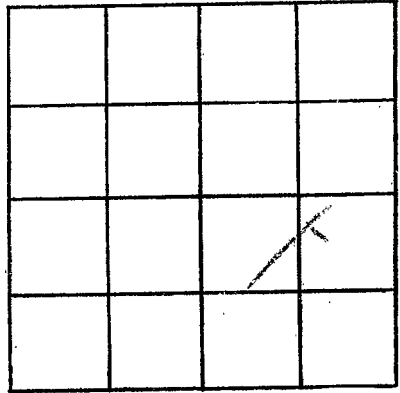

SECTION 11

Please indicate well location X.

ADDITIONAL INFORMATION

If more than one screen, show locations of each on sketch.