

Pike  
F-46  
8-21-71

MISSISSIPPI  
BOARD OF WATER COMMISSIONERS  
416 North State Street  
Jackson, Mississippi 39201

WATER WELL DRILLERS LOG

**CODED**

Aug 21 1971 date well completed  
chestertown firm name  
counties well located

LANDOWNER: Colvin  
Nowak  
Rt 3, Tylertown  
(mailing address)

description of formations encountered	from	to
clay shale	0	12
fine gravel	12	22
white chalk	22	60

WELL LOCATION:  
sec 23 T 3 N R 9 E  
2 miles E Helmville  
(distance) (direction) (nearest town)

Coarse sandstone	60	73
gravel		

WELL PURPOSE: Home  
(home, irrigation, municipal, industrial)

- WELL COMPLETION DATA:
- (1) diameter (inches) 4"
  - (2) total depth (feet) 73
  - (3) static water level (feet) 47 below top of ground.
  - (4) casing Plast bottom  
(material) (depth)
  - (size) if telescope see back.
  - (5) screen 6' 67'  
(length) (depth to top)
  - 1/2" Plast  
(size) (material)
  - (6) pump 1/2 sub 15  
(HP) (yield gpm)
  - Elect  
(type power)
  - (7) electric log NO  
(yes or no)
  - (organization running log)

**CODED**


(8) how well bottom plugged wooden plug

DRILLERS REMARKS: New location

SEP 20 1971

If well telescopes please sketch and show depths.

GROUND LEVEL

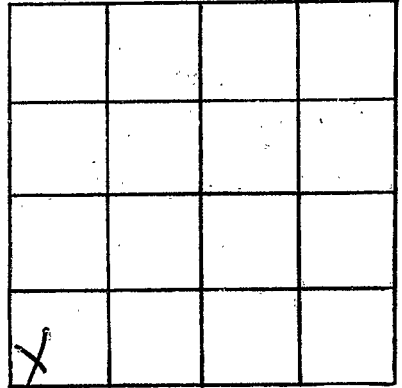

SECTION 2B

Please indicate well location X.

ADDITIONAL INFORMATION

If more than one screen,  
show locations of each on sketch.